

Name John J. Balsano

Service No. 78 (74)

Address #280 Woburn Street

280 Woburn Street

Location

Kind of Pipe

Size 6" A.C.

Size of Main

Repair—Renewal—New Service

VALERI CONVS 10/24/74

Location

AUG 16 1976

Date	Material	Amount	Total	Date	Amount
July 22 1974	<del>18' <del>ACR</del></del>	9.00 ft.	<del>162.00</del>	10/8/74	162.00
10/24/74	35' 6" Transite Pipe			Deposit	
	7' 4" Cast Iron Pipe				
	Repair W.O. #886				
11-9-79	Labor				
	1 6" x 3' Nipple Transite				
	1 6" 22 1/2° Transite Elbow				
	1 6" Transite Sleeve				
	Patch 3' x 8'				
	2 1/2 hrs. Trucking				
	1 1/2 hrs. Town Shovel				
8/23/82	VALERI			8-23-82	Put in service @ 40'
	41' 6" P.V.C.			3-28-82	S.B. 10' int. Insulated for their region
	2 22 1/2 x 6" P.V.C. Elbow			11-9-79	Rate 19' int.
	1 6" x 4" Rubber Donut			11-19-81	Check to see how far O in Service to location
					Next stop...
				4-26-82	Service restored with same amount to get from here
				8-13-82	Rate 42' int. Insulated


DATE July 22, 1974

TOWN OF LEXINGTON — BOARD OF PUBLIC WORKS

SEWER DIVISION

280

Sketch of Service Here

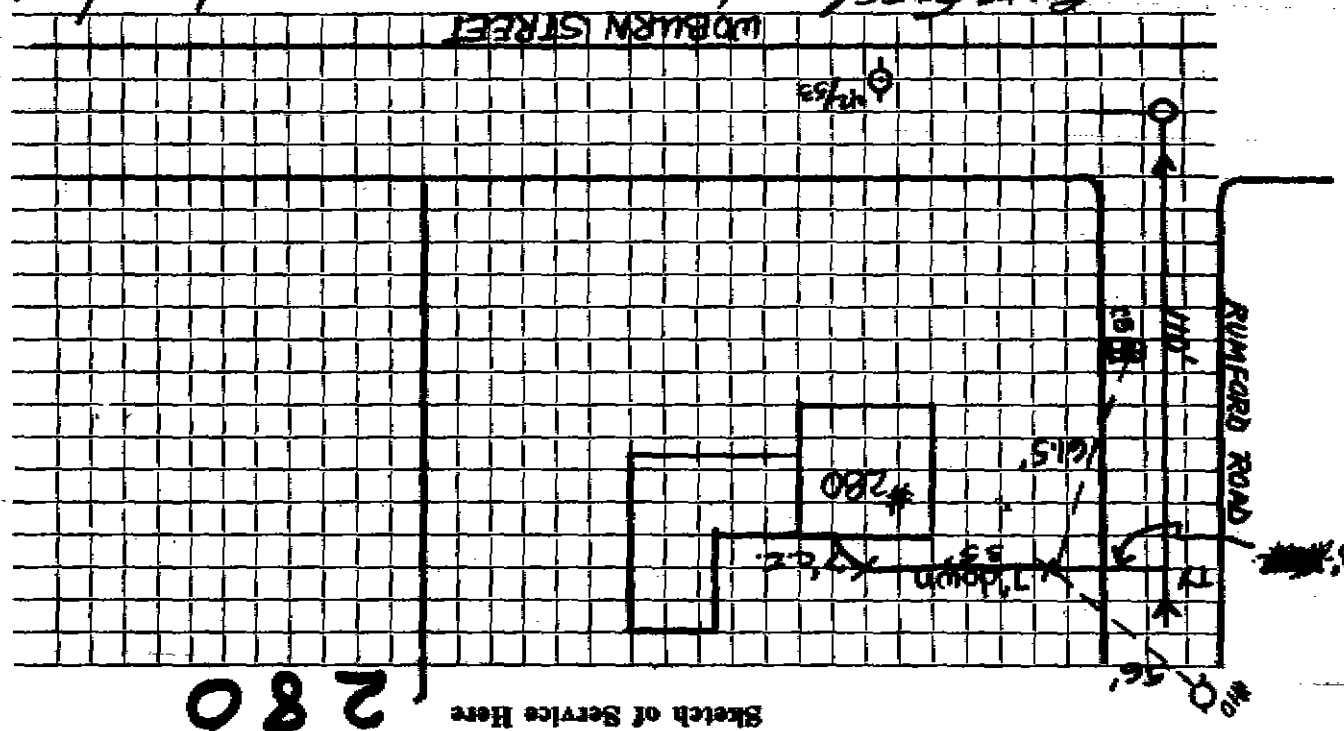

Connection made in ~~380~~ Rumford St. Street. Work completed 10/24/74

Remarks: