

TOWN OF LEXINGTON — BOARD OF PUBLIC WORKS

**SEWER DIVISION**

DATE 7/20/21

Sketch of Service Here

\* Foundation NOT  
built @ time  
of install

4" 4" Clement  
Exx Frame 12'  
6" SDR-35

65' 53'

6" Ferro to HC Pipe

Sidewalk

sewer  
m

36' Elec. M/H

WOBURN ST

Connection made in WOBURN

Street.

Work completed

Remarks:

Name McLaughlin, James

Service No. WW-21-55

Address 286 WOBURN ST

Kind of Pipe	Size	Location	
		Repair—Renewal	New Service
Date	Material	Amount	Total
7/20	6" Ferco (AC → SDR)	①	
	6" SDR - 35 Pipe	~53'	
	4" PVC Pipe	~2'	
	4" cleaned	①	
	6" sleeve over		
	4" Pipe under footing		

Name Little Ambrose

Service No. 78

Address #286 Woburn Street  
286 Woburn Street

JUN 26 1977

Location

Size of Main 8 "

Size 6 "

Location Sewerage #2869

New Service

Kind of Pipe	Date	Material	Amount	Total	Date	Amount
10/2/74 25' A.C.		8.00	\$ 200.00	1/17/75	Deposit	200.00

Remarks:

Connection made in .....


Street.

Work completed

WOBURN STREET

Aug 29, 1965

251AC

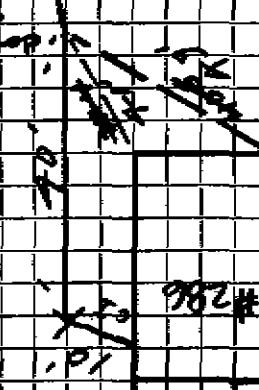

Sketch of Service Here

286

## SEWER DIVISION

TOWN OF LEXINGTON — BOARD OF PUBLIC WORKS

DATE