




DATE \_\_\_\_\_

**TOWN OF LEXINGTON — BOARD OF PUBLIC WORKS**  
**SEWER DIVISION**

Sketch of Service Here

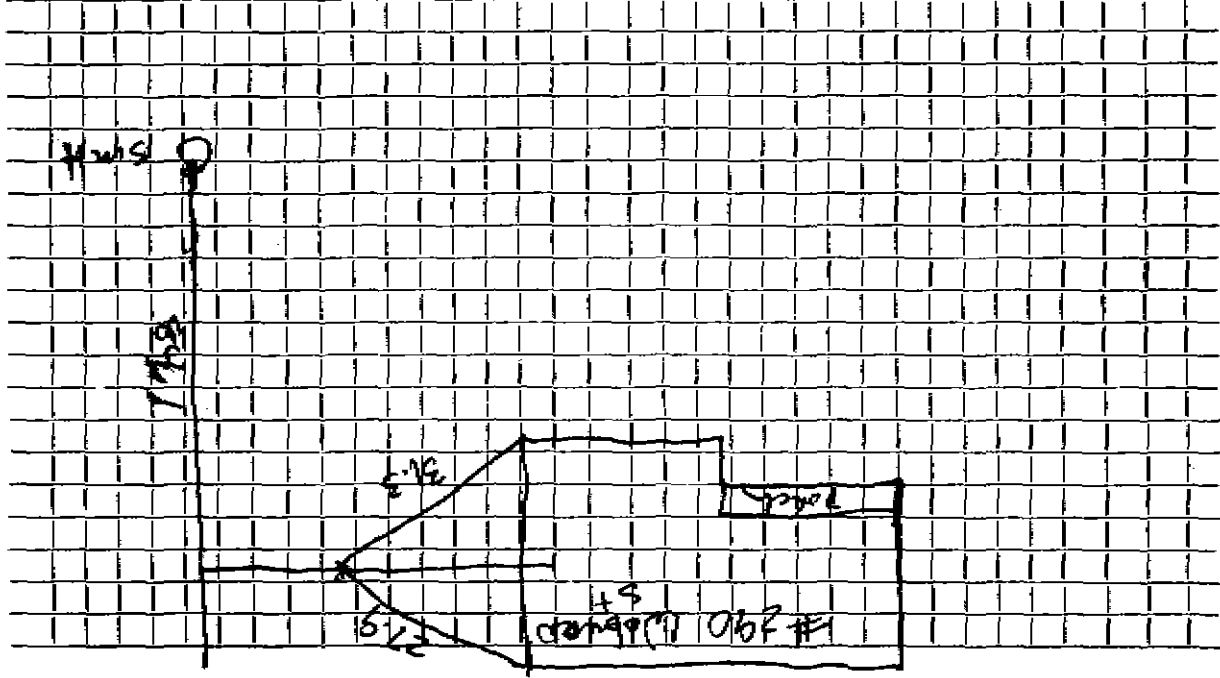

Street. \_\_\_\_\_  
Work completed \_\_\_\_\_

Connection made in \_\_\_\_\_  
Remarks: Sewer service installed to main in Pt of work