




TOWN OF LEXINGTON — BOARD OF PUBLIC WORKS

SEWER DIVISION

DATE

Sketch of Service Here

292

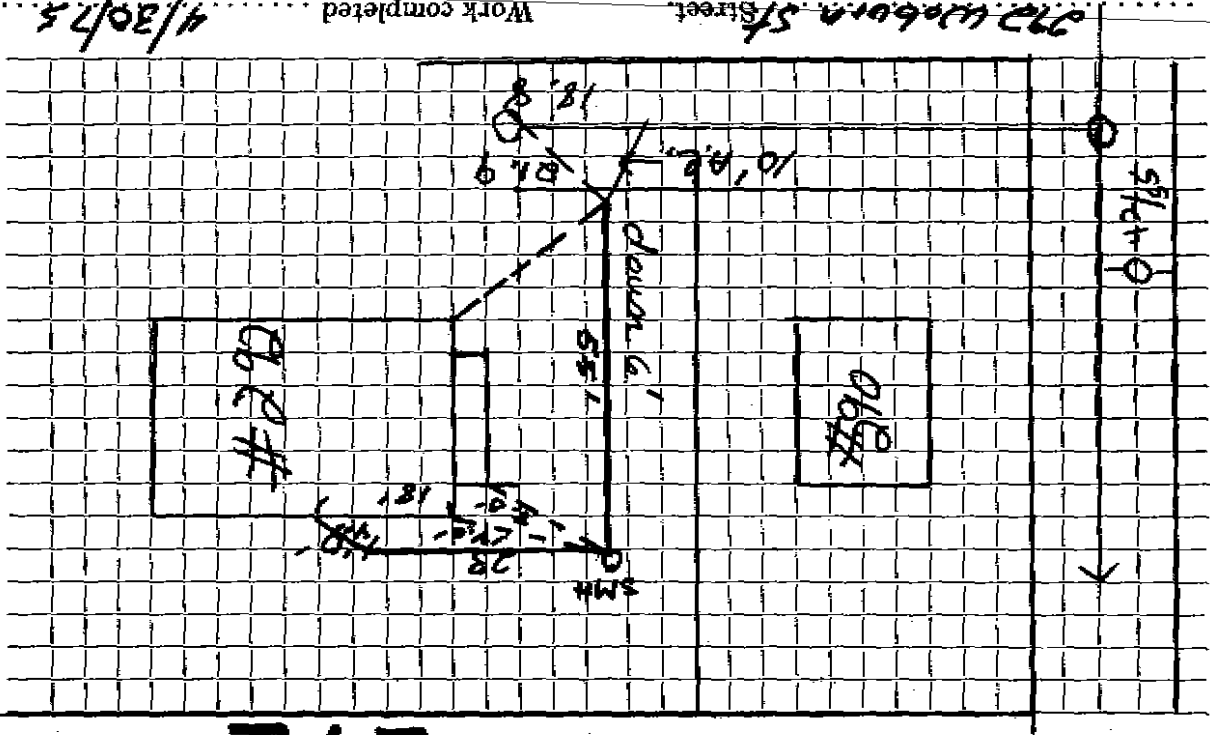

Connection made in

292 Woburn Street

Work completed

4/30/75

Remarks: