




TOWN OF LEXINGTON — BOARD OF PUBLIC WORKS

SEWER DIVISION

DATE \_\_\_\_\_

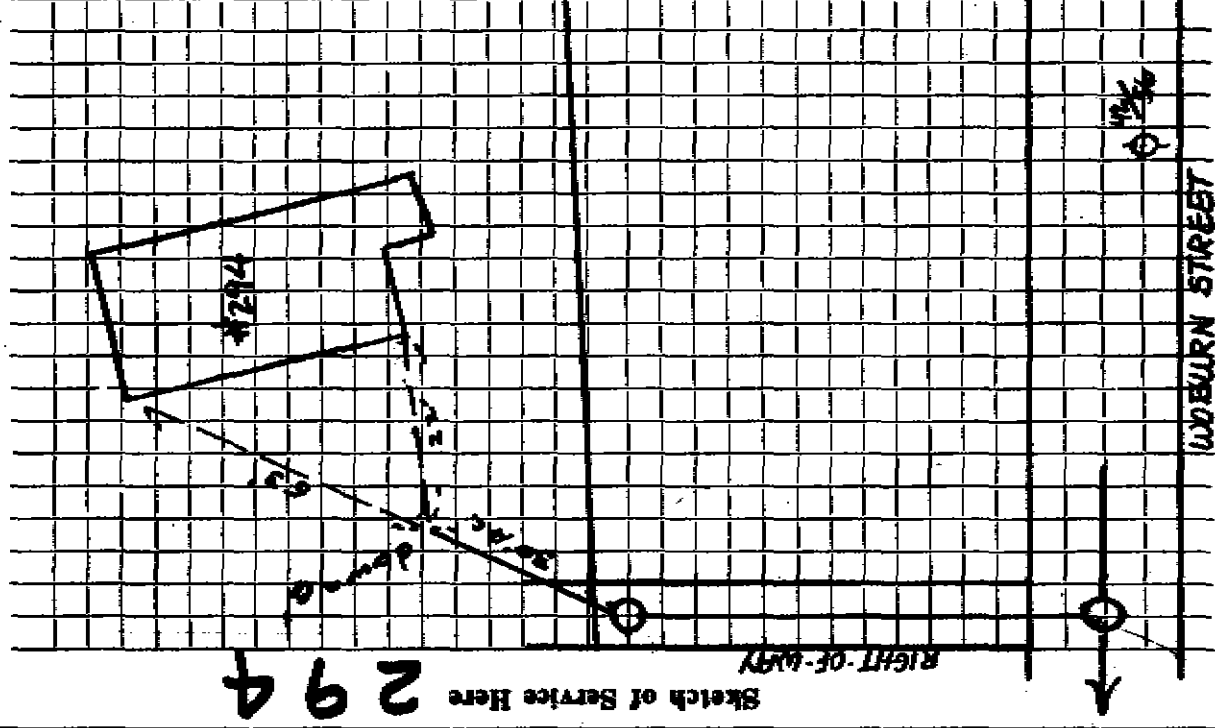

Sketch of Service Here

RIGHT-OF-WAY

WDEURN STREET



Street. Work completed

Connection made in

Remarks: