


SEWER DIVISION

Sketch of Service Here
296

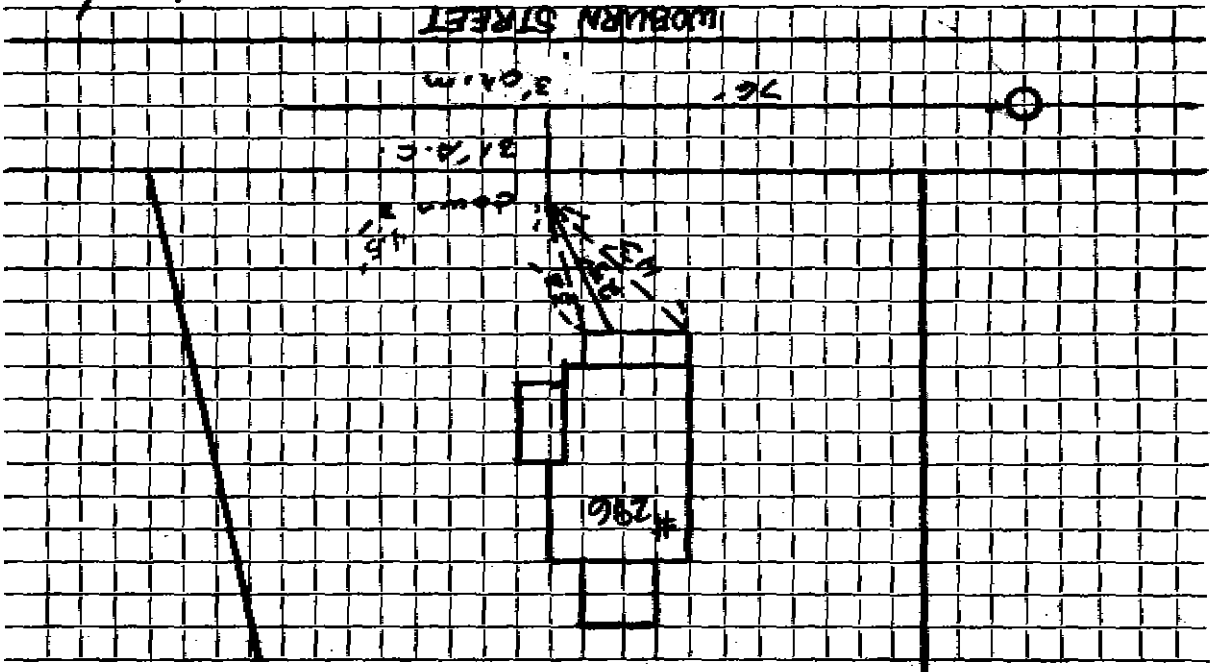

Connection made in 296 Woburn St. Street. Work completed 10/23/74

Remarks: