




DATE 9-14-82

TOWN OF LEXINGTON — BOARD OF PUBLIC WORKS

### SEWER DIVISION

Sketch of Service Here  
**303**

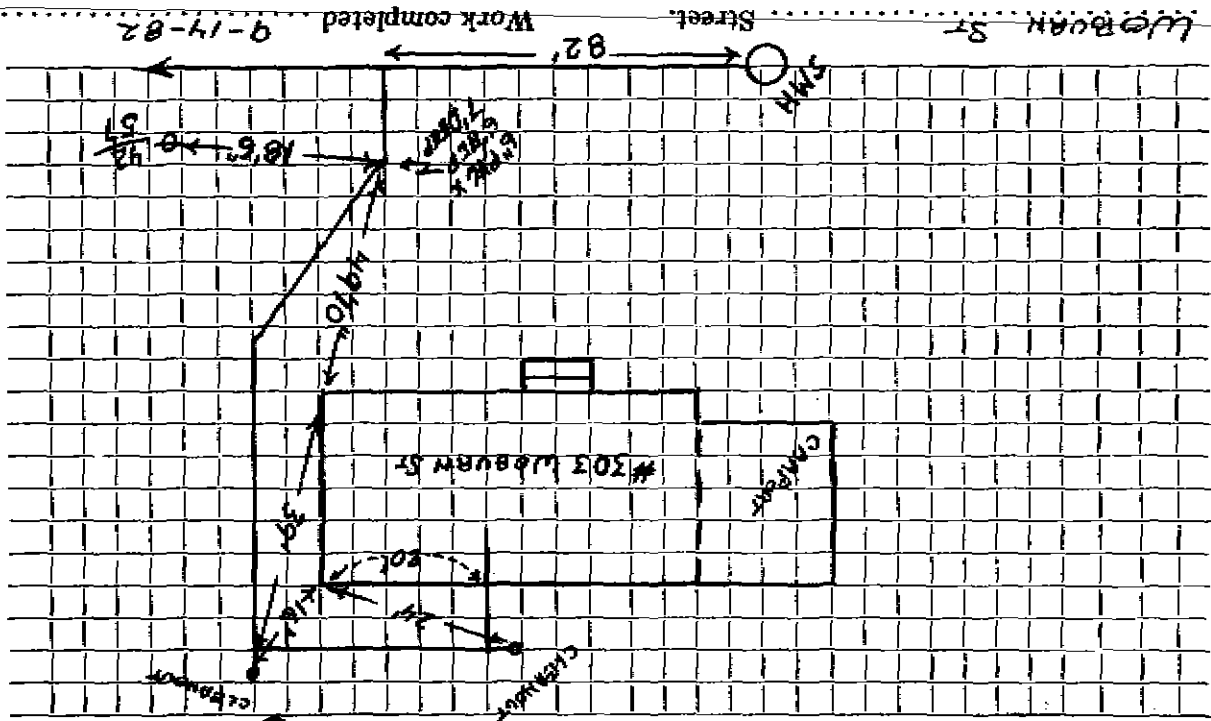

Remarks: