

Name Michael DeRosa

Service No. 22

Address #306 Waburn Street
306 Waburn Street

Location

Kind of Pipe A.C.

Plumber/Steamfitter New Service Valeri #4143

Size 6"

Size of Main 8"

Location

AUG 26 1986


Date	Material	Amount	Total	Date	Amount
10/2/74	25' A.C.	\$00	\$200.00	7-15-85	Lyman
7/22/85	40'	6"	PVC		
	4"	Iron Stub			
	4"	Donut			
	1	30° Sweep			
	1	22° Bend			
	1	A.C. to PVC Adpt			
	1	PVC Coupling			

Remarks:

Connection made in

Street.

Work completed

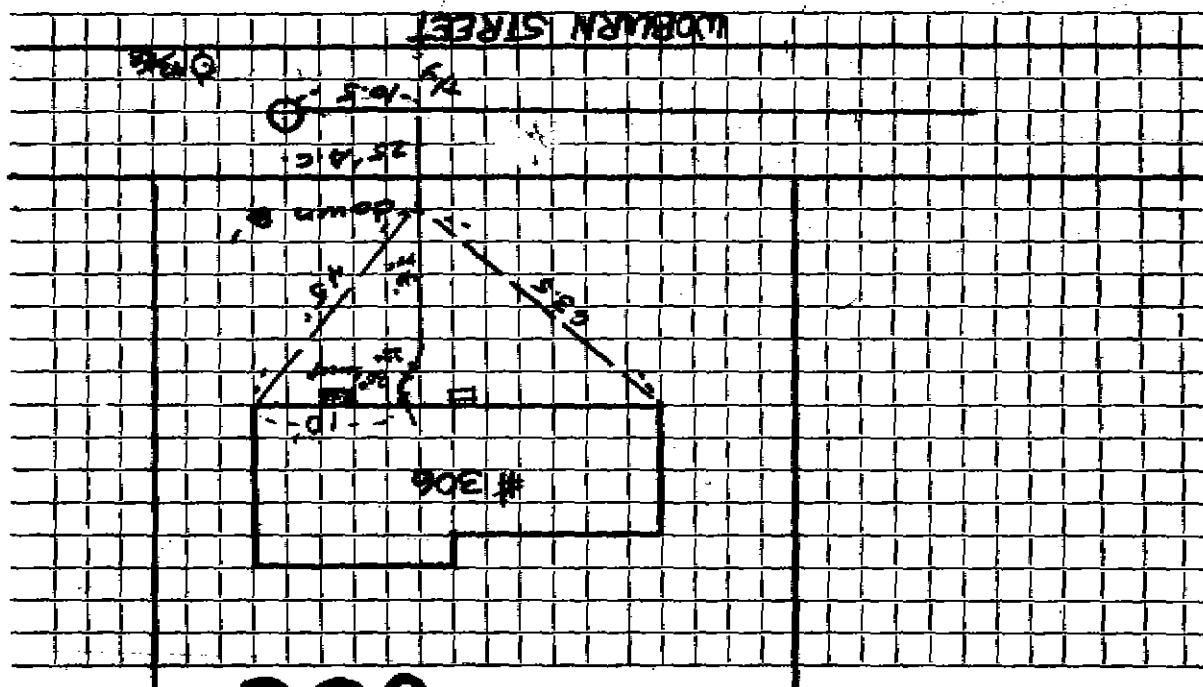

Sketch of Service Here **306**

SEWER DIVISION

TOWN OF LEXINGTON — BOARD OF PUBLIC WORKS

DATE