

Name

Service No.

Address 327 WOBURN Street

327 Woburn Street

Location

Kind of Pipe

Size 6"

Size of Main 8"

Repair—Renewal—New Service

Location

Date		Material	Amount	Total	Date	Amount
1967	28 ¹	6" Transite pipe @7.00		196.00		

TOWN OF LEXINGTON — BOARD OF PUBLIC WORKS


SEWER DIVISION

DATE

57

Sketch of Service Here

327

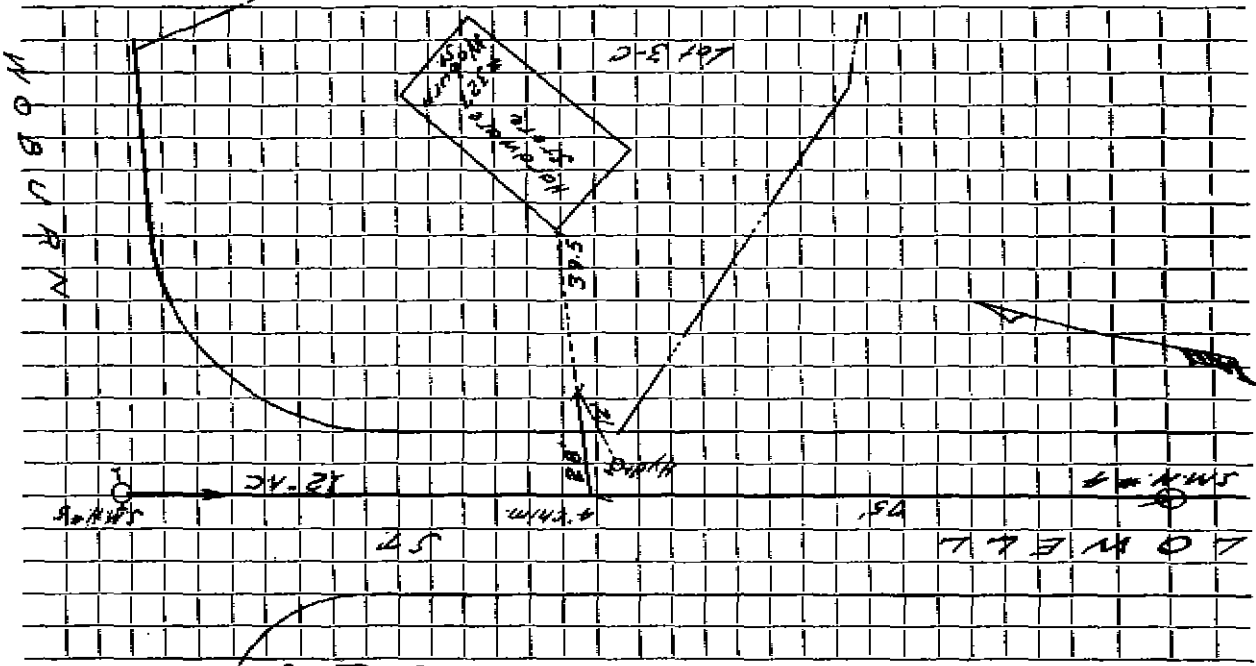

Work completed

Street

Connection made in

Remarks:

Name

Service No.

Address 327 Woburn Street

Lot #30 **327 Woburn Street** Location

Kind of Pipe

Size **6"**

Size of Main **8"**

Repair—Renewal—New Service

Location


Date	Material	Amount	Total	Date	Amount
1970	197	6" Transite pipe @9.00	171.00		

DATE _____

TOWN OF LEXINGTON — BOARD OF PUBLIC WORKS

SEWER DIVISION

Sketch of Service Here **327**

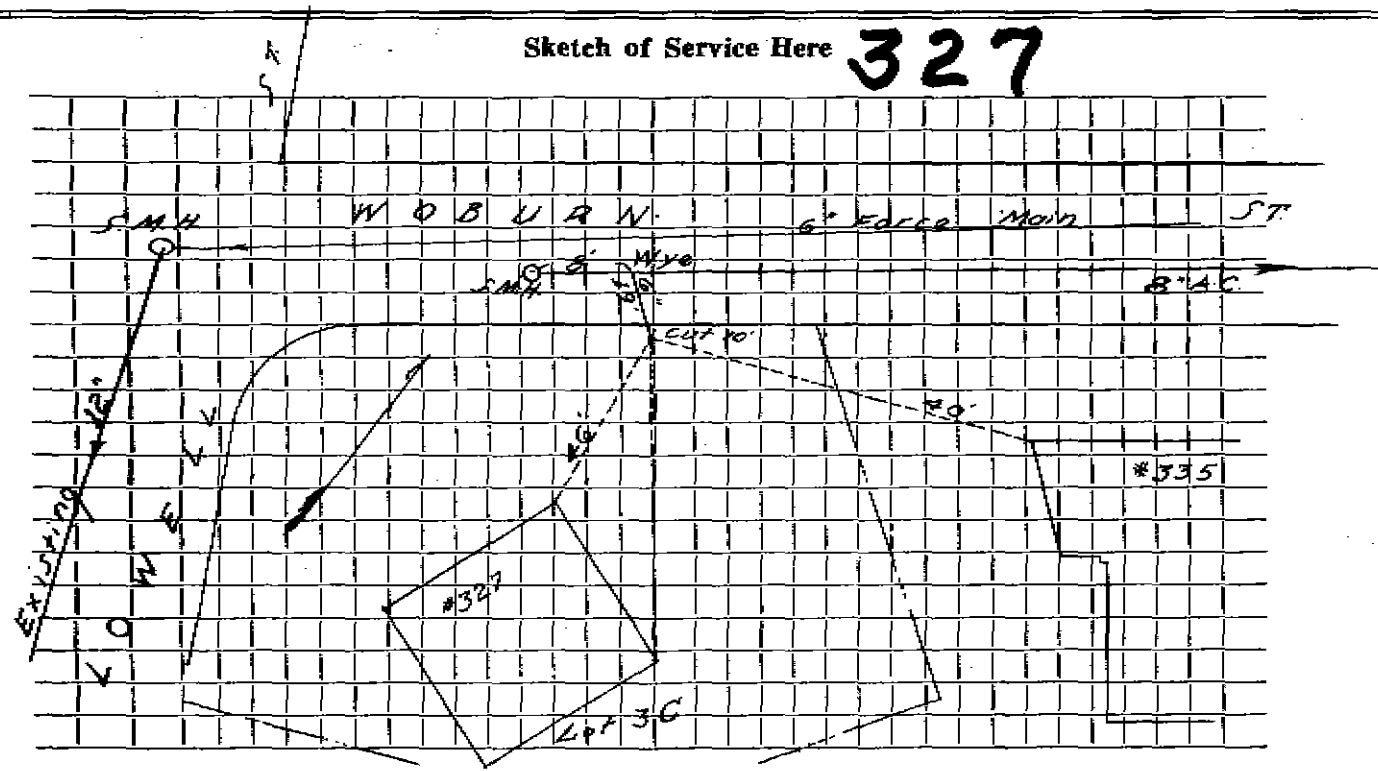

Connection made in _____ Street. Work completed _____

Remarks: _____

