


DATE _____

TOWN OF LEXINGTON — BOARD OF PUBLIC WORKS

SEWER DIVISION

Sketch of Service Here

334

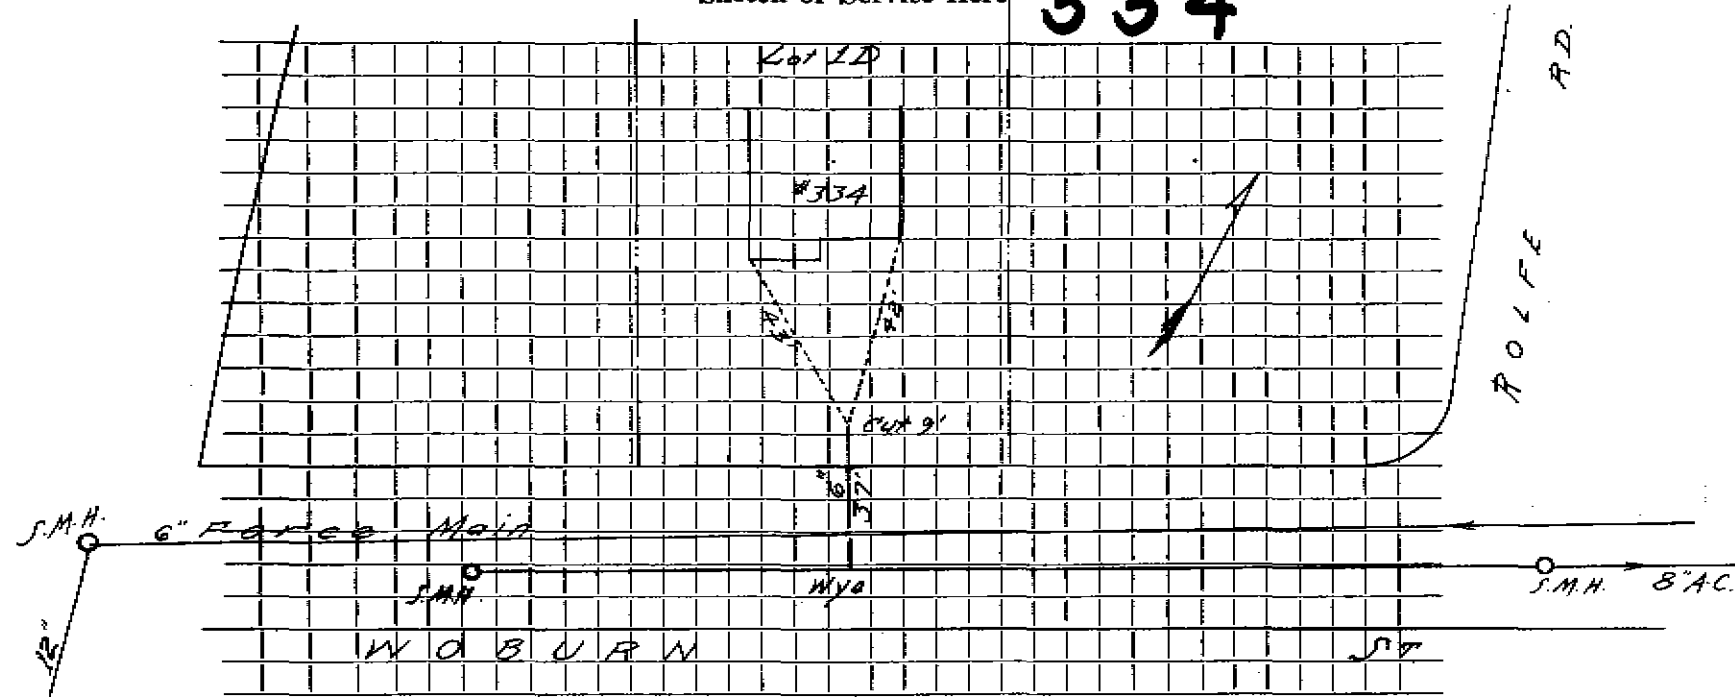

Connection made in _____ Street. Work completed _____

Remarks: _____

