

Name

Service No.

Address

337 Woburn St

Location

Kind of Pipe

Size

Size of Main

Repair—Renewal—New Service

Location

Date

Material

Amount

Total

Date

Amount

11-09

Inside renewed  
 10'-4" PVC  
 4x6 Franco  
 36' 6" PVC  
 6x6 PVC to AC Franco  
 6" 11" Brawl


1970

25' - 6" AC pipe

DATE \_\_\_\_\_

**TOWN OF LEXINGTON — BOARD OF PUBLIC WORKS**  
**SEWER DIVISION**

Sketch of Service Here

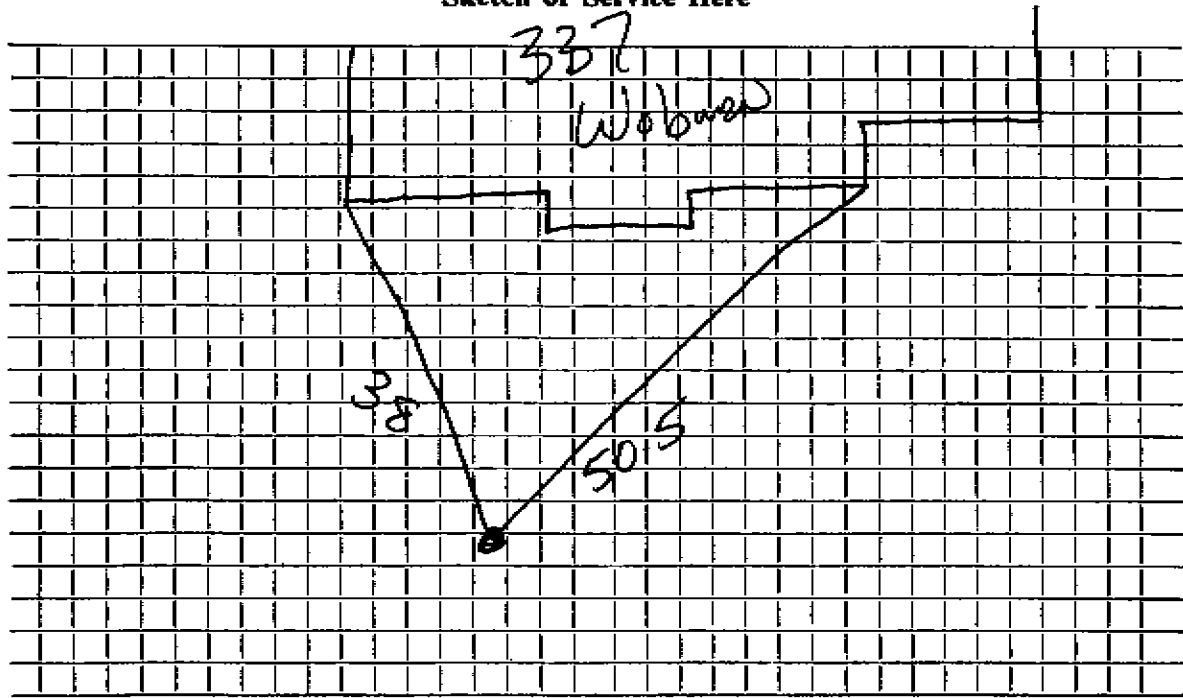

Connection made in ..... Street. Work completed .....

Remarks: .....  
.....  
.....