




DATE 6-9-88

TOWN OF LEXINGTON — BOARD OF PUBLIC WORKS  
SEWER DIVISION

Sketch of Service Here **338**

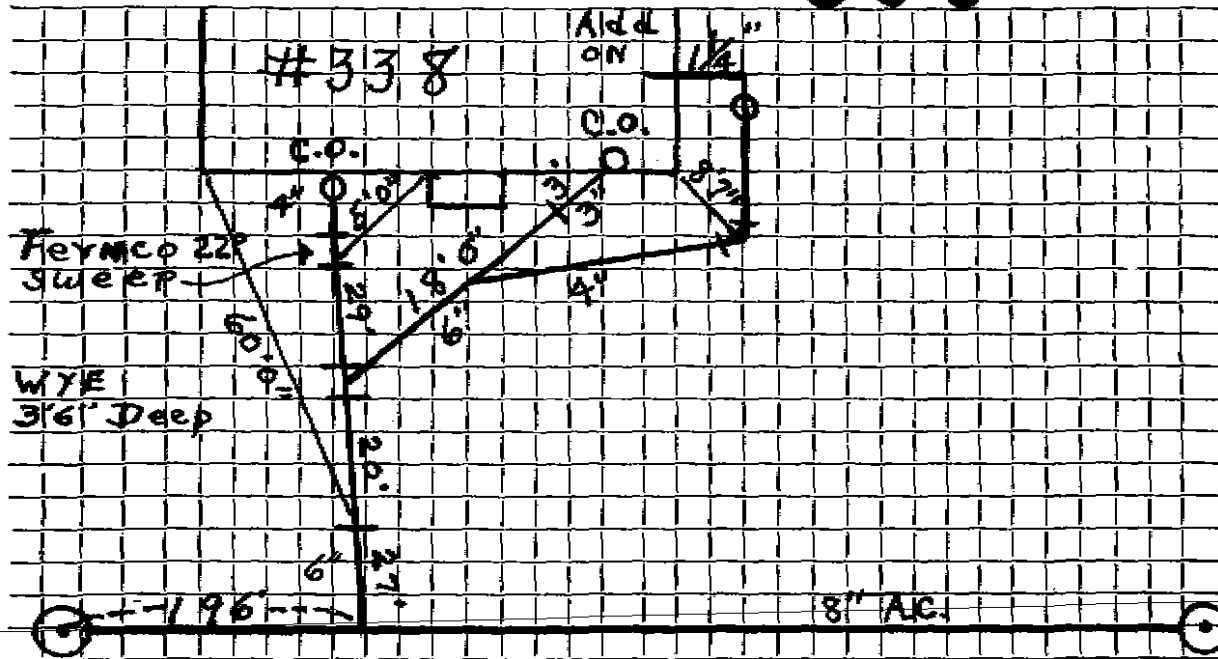

Connection made in ..... Street. Work completed .....

Remarks: 1 1/2" PVC for Wash machine .....