

Name

Service No.

Address 346 Woburn St

Location

Kind of Pipe

Size

Size of Main

Repair—Renewal—New Service


Location

Date	Material	Amount	Total	Date	Amount
12-13-00	Inside Renewed to wye				
	10' - 4" PVC				
	16' - 6" PVC				
	4x4x4 wye clampout				
	6x6x6 wye				

DATE \_\_\_\_\_

**TOWN OF LEXINGTON — BOARD OF PUBLIC WORKS**  
**SEWER DIVISION**

Sketch of Service Here

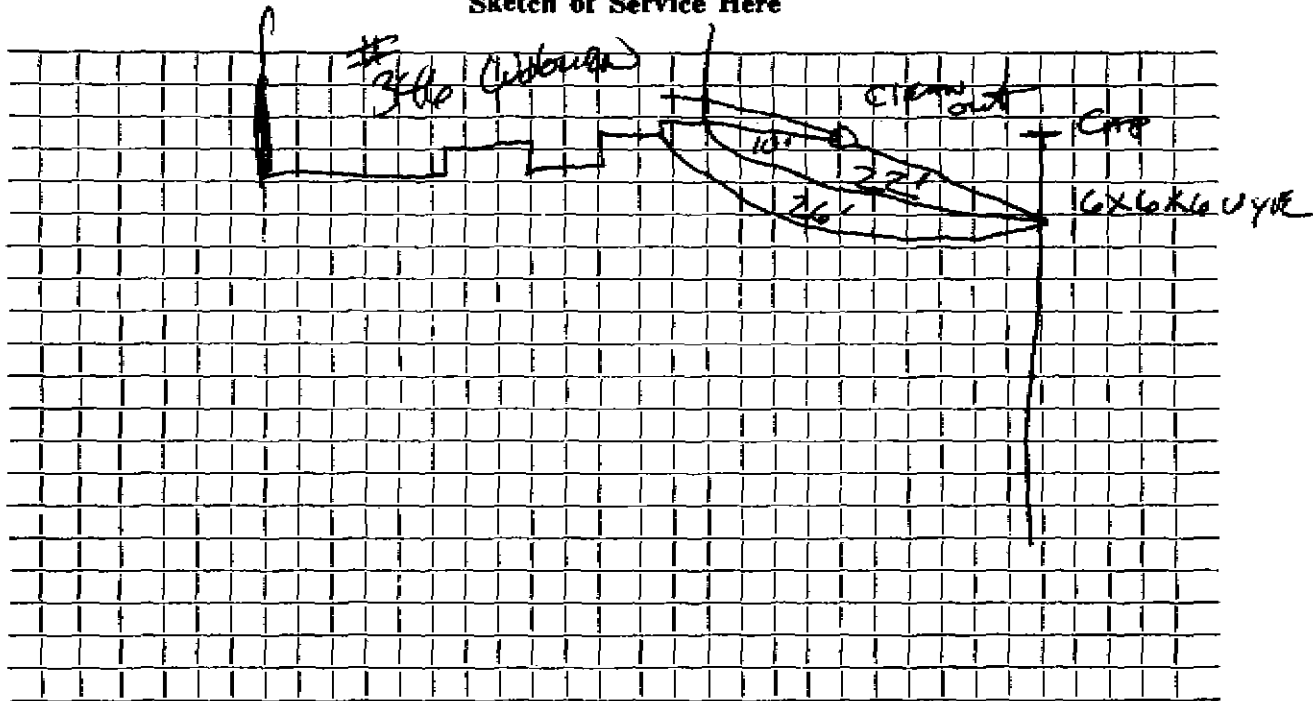

Connection made in \_\_\_\_\_ Street. Work completed \_\_\_\_\_

Remarks: House torn down new service  
installed for new house