

Name **D. E. O'Connell** Service No. **70 1879**

Address **35-57-39** Stores-Moburn St.

Location

Kind of Pipe Size **6"** Size of Main **8"**

Repairs-~~Present~~ - New Service Location

Date	Material	Amount	Total	Date	Amount
<i>2/11/35</i>	12" Clay Pipe @ .30	5 70			
<i>for</i>	10" Iron Pipe @ .50	5 00		<i>Chk 31 1925- Cash</i>	<i>AS 72</i>
<i>35.73</i>	Sulphur & Jute	<u>76</u>		<i>1-6-53</i>	
	Trucking	<u>75</u>	12 21	<i>4' 6" Sewer Pipe</i>	
<i>50/3/28</i>	hrs. Labor @ .55	19 25			
<i>2</i>	" " @ .60	<u>1 20</u>	20 45		
	15% Overhead		<u>3 07</u>		
			35 73		
	Labor				

TOWN OF LEXINGTON—BOARD OF PUBLIC WORKS
SEWER DIVISION

DATE _____

NO. _____


The undersigned applies for the construction of a particular sewer connecting No. _____
Street and hereby agrees to comply with the Rules and Regulations governing the construction and use of Particular
Sewers, as now or at any future time established by the Board of Selectmen.

Am't. of Estimate \$ _____

Am't. Paid \$ _____

Owner

Sketch of Service Here

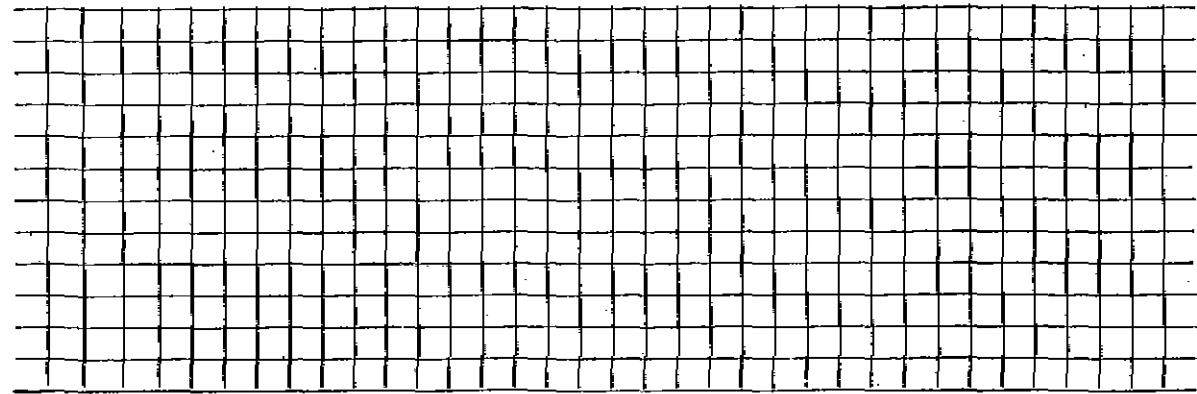

Connection made in _____ Street. Work completed _____ 19

Remarks: