




TOWN OF LEXINGTON — BOARD OF PUBLIC WORKS

SEWER DIVISION

DATE

Sketch of Service Here

353

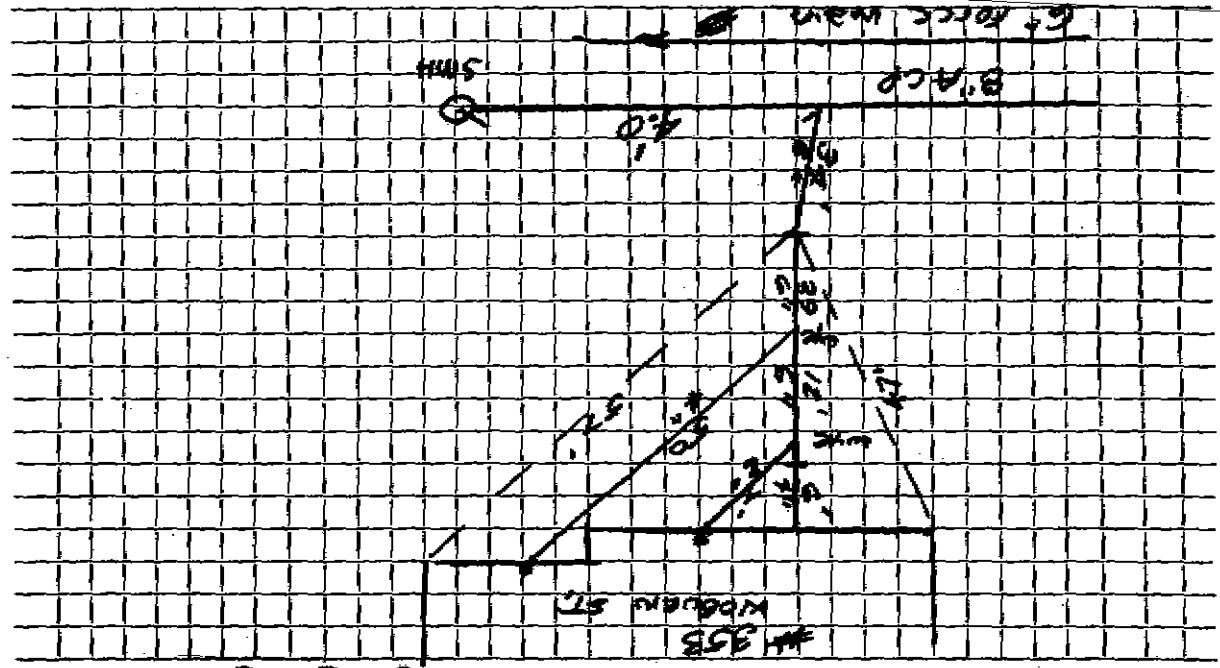

Connection made in Woburn Street. Work completed

Remarks: