


DATE 8/7/90

TOWN OF LEXINGTON — BOARD OF PUBLIC WORKS
SEWER DIVISION

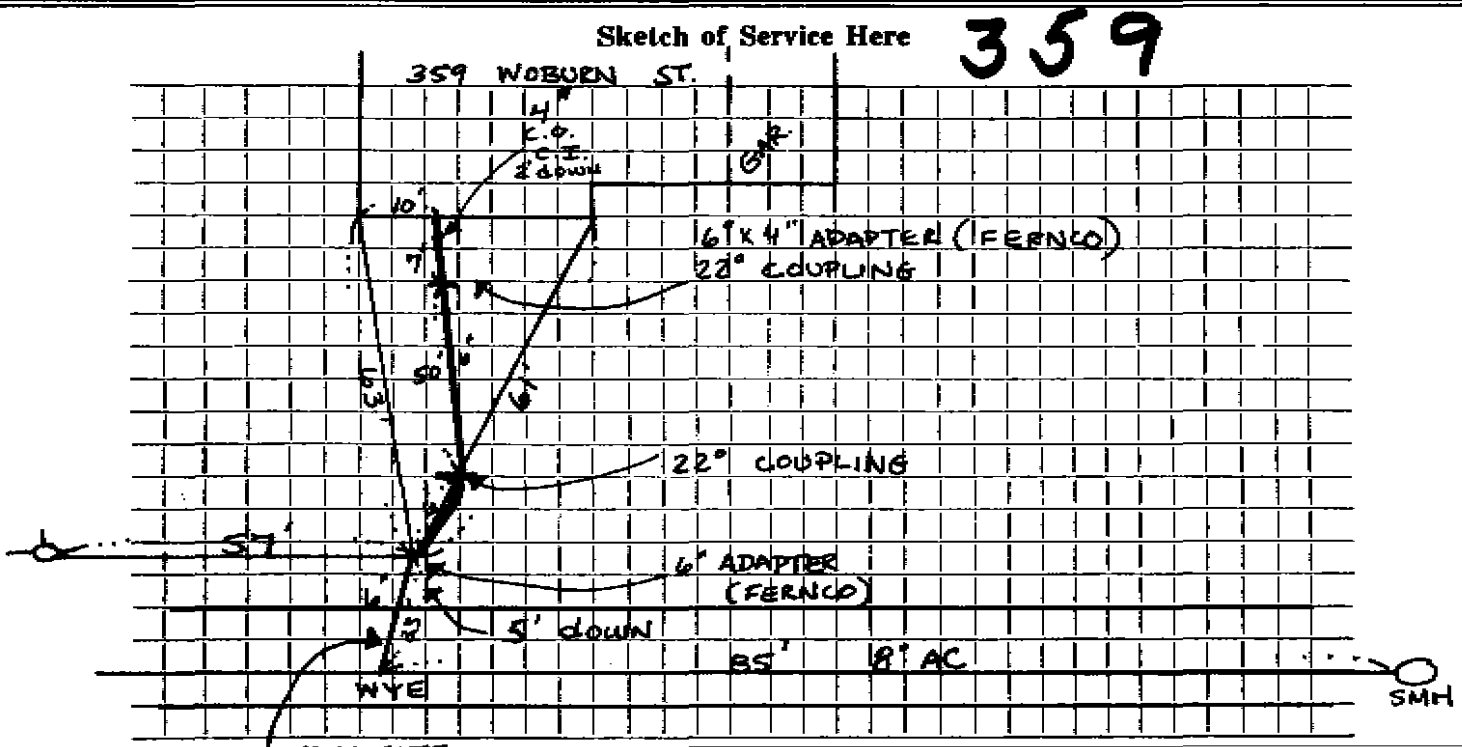

Connection made in 359 WOBURN Street. Work completed

Remarks: INSPECTOR: P. A. BARROWS

CONTRACTOR: KIRKLAND & SHAW