




DATE \_\_\_\_\_

**TOWN OF LEXINGTON — BOARD OF PUBLIC WORKS**  
**SEWER DIVISION**

Sketch of Service Here

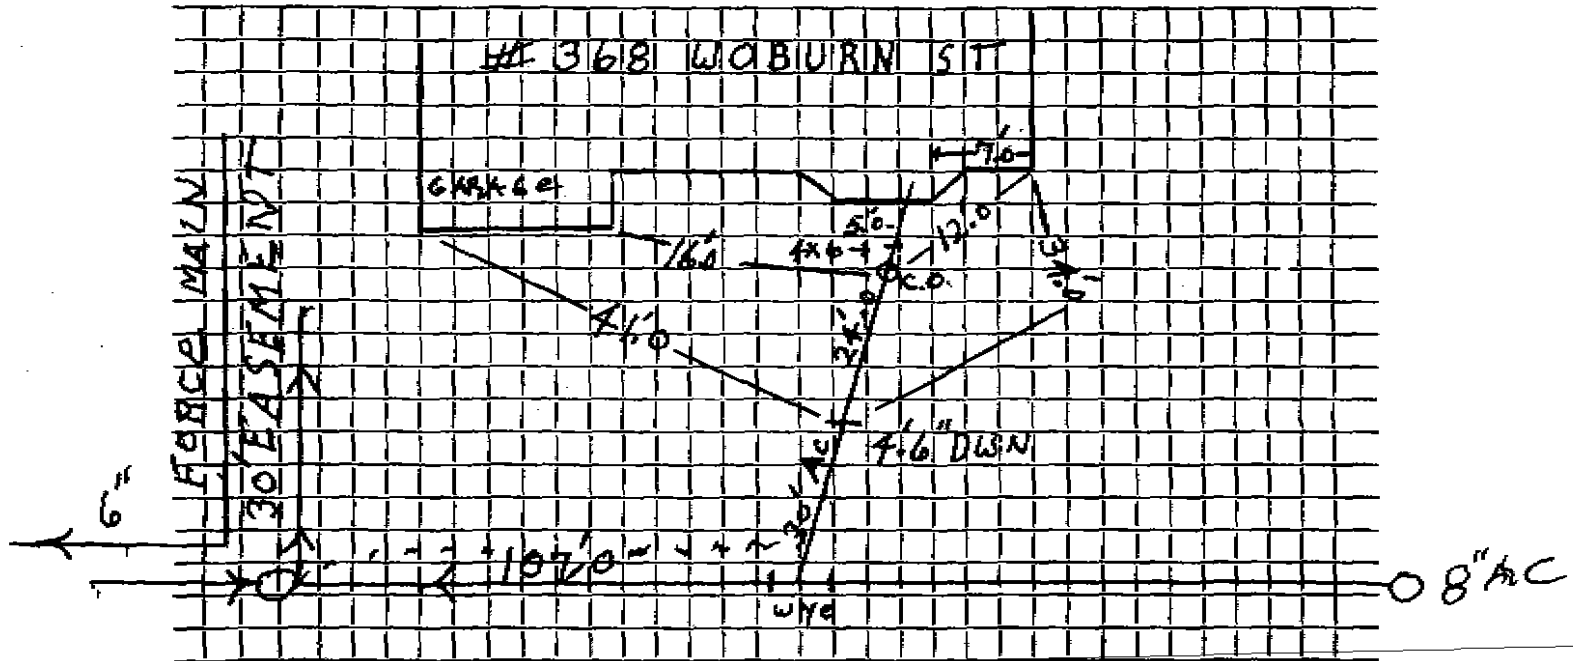

Connection made in ..... Street. Work completed 11/15/06 J. McLaughlin.....  
Remarks: 6" CLEAN OUT 15' 7.0" FROM FOUNDATION WALL.