

Name Richard Powers

Service No. 71

Address 374 Woburn Street

Lot 5 374 Woburn Street Location Lot 5

Kind of Pipe

Size 6"

Size of Main 8"

Repair—Renewal—New Service Valeri #1693

Location SEP 21 1970


Date		Material	Amount	Total	Date	Amount
1970	30	6" Transite pipe @9.00	-	270.00	7-24-70	270.00
8-12-70	59.5'	6" Transite pipe			<i>Deposit</i>	
	12'	4" Cast Iron pipe				

DATE \_\_\_\_\_

TOWN OF LEXINGTON — BOARD OF PUBLIC WORKS  
SEWER DIVISION

374 Sketch of Service Here

Lot 5

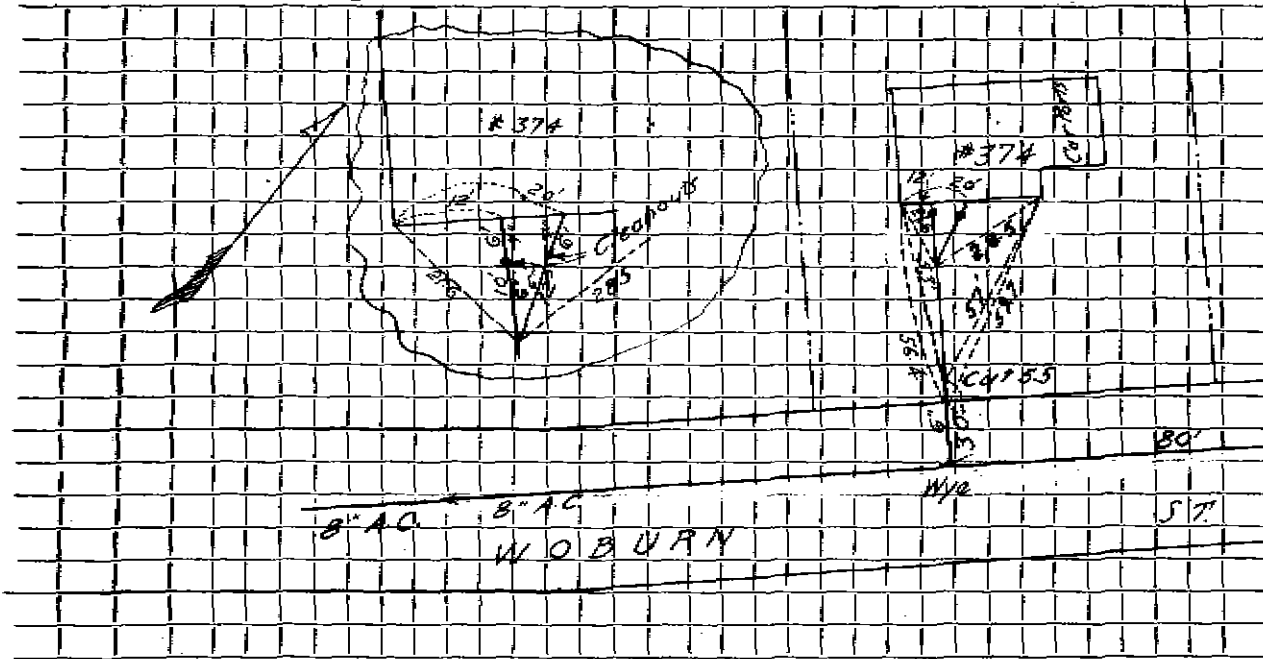

Connection made in ..... Street. Work completed .....

Remarks: .....

.....

.....