


DATE _____

TOWN OF LEXINGTON — BOARD OF PUBLIC WORKS
SEWER DIVISION

Sketch of Service Here

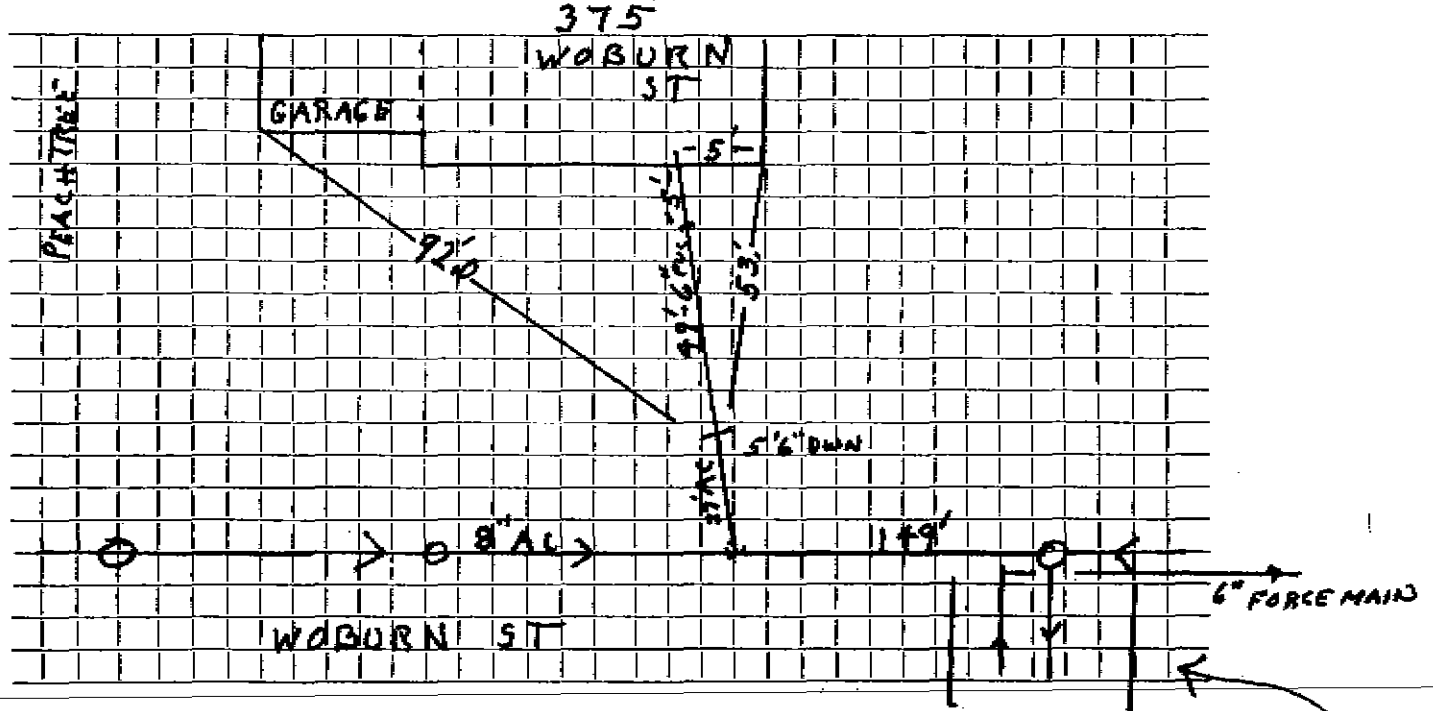

Connection made in Street. Work completed

Remarks: 2/31/91. REPAIRD SEWER SERVICE UNDER WATER MAIN (4" 6" PVC - 2 FORMLO³)
30' SEWER PARIN ENGEMENT.