

Name Helen M. Gulliana

Service No. 95

Address 379 Woburn Street

Lot 2 **379 Woburn Street** Location Lot 2

Kind of Pipe

Size 6"

Size of Main 8"

Repair—Renewal—New Service Craftsman #1743

Location APR 21 1971


Date	Material	Amount	Total	Date	Amount	
1970	21' 6" Transite pipe @9.00		189.00	10-1-70	Deposit	189.00
10-5-70	126' 6" Transite pipe					
	18' 4" Cast Iron pipe					

DATE _____

TOWN OF LEXINGTON — BOARD OF PUBLIC WORKS

SEWER DIVISION

Sketch of Service Here **379**

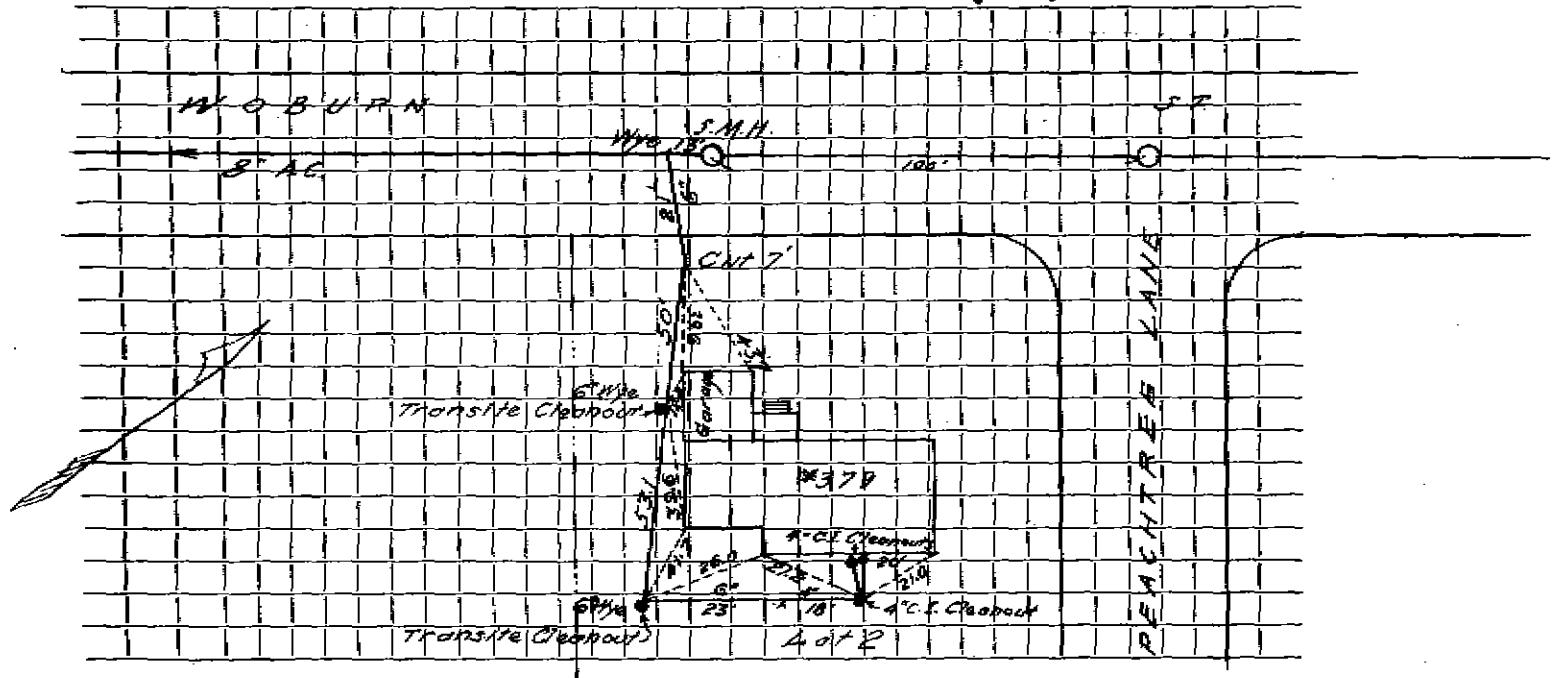

Connection made in Street. Work completed

Remarks:
.....
.....