




DATE 1970

TOWN OF LEXINGTON — BOARD OF PUBLIC WORKS  
SEWER DIVISION

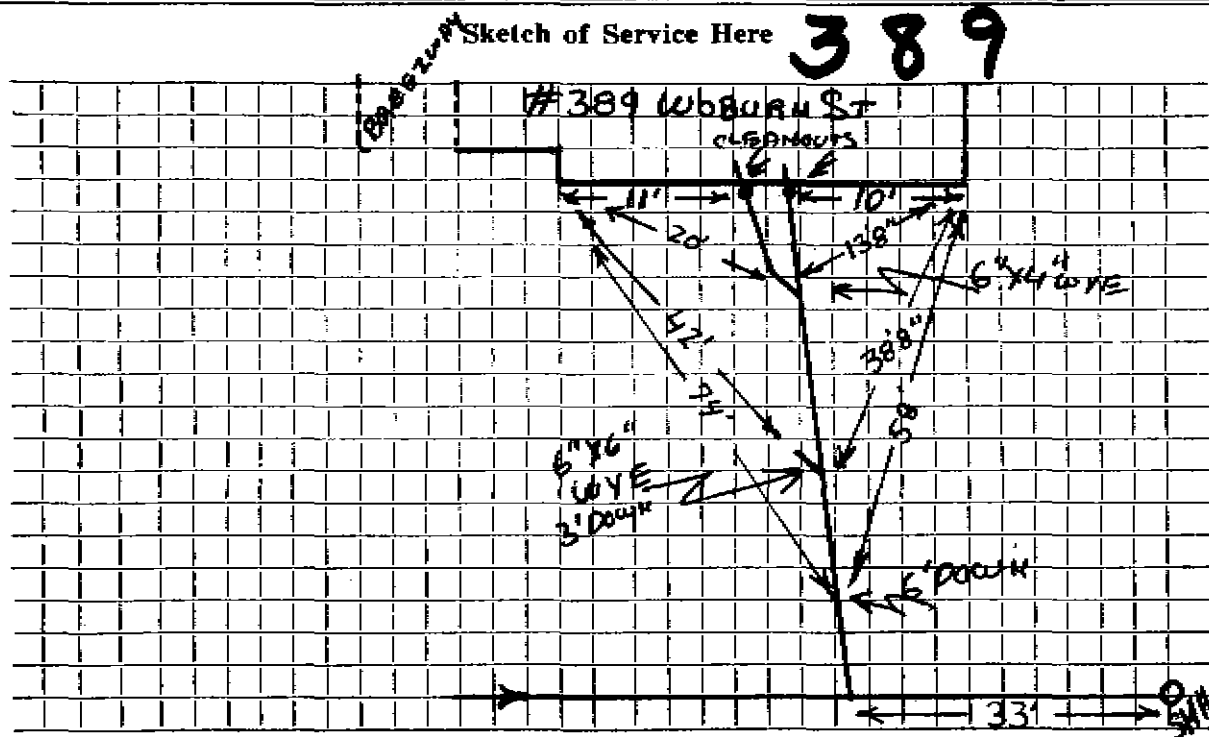

Connection made in WORBAN ST Street. Work completed JUN 12 1986.

Remarks: .....

.....

.....