

DATE _____


TOWN OF LEXINGTON

BOARD OF PUBLIC WORKS

SEWER DIVISION

Sketch of Service Here

393-505

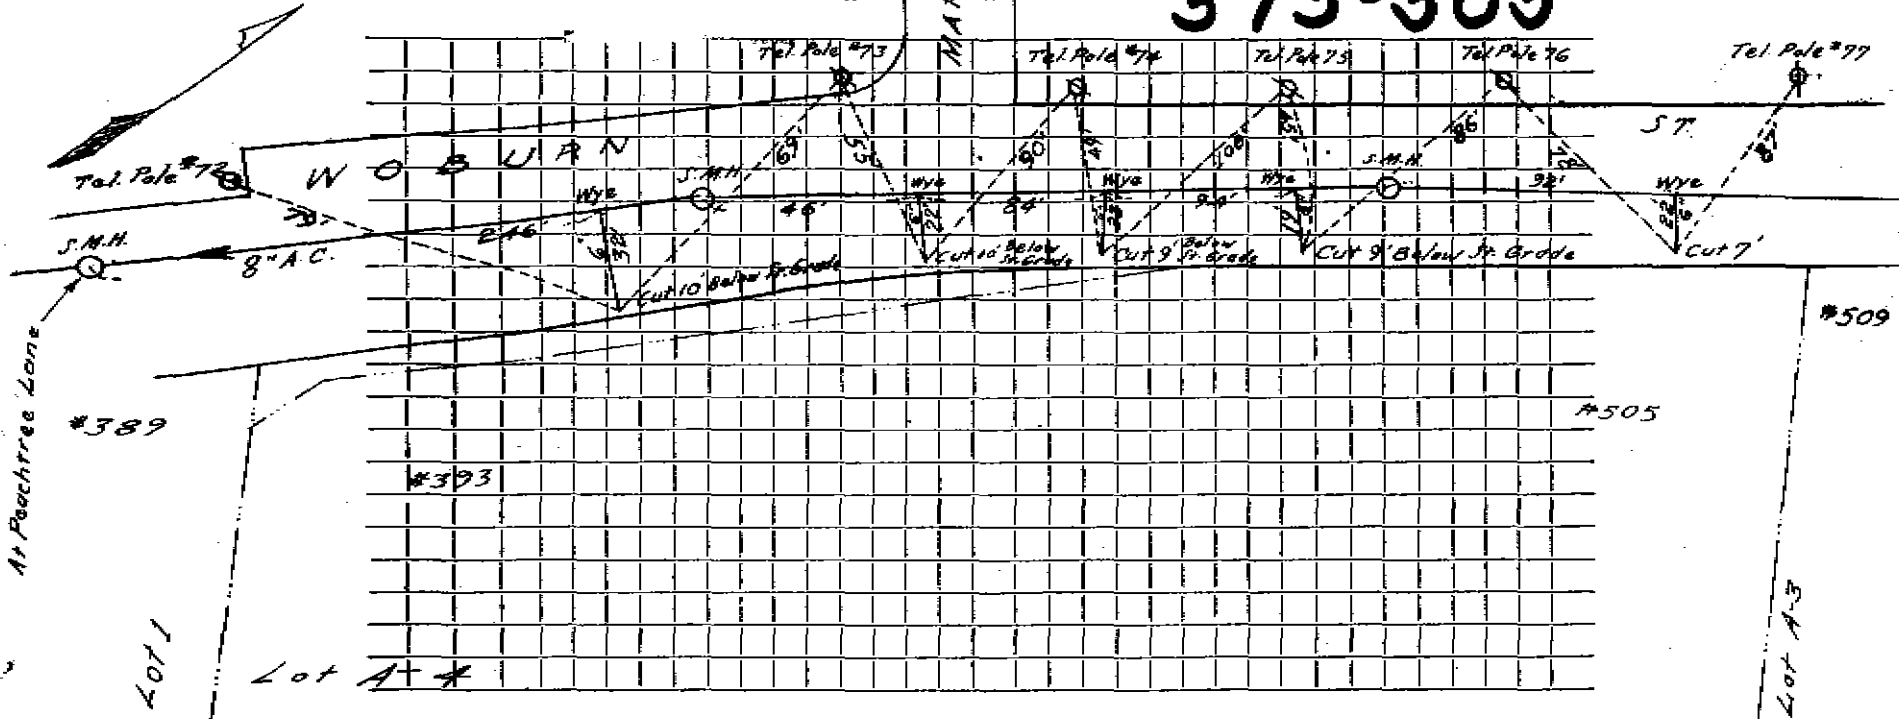

Connection made in Street. Work completed

Remarks:

.....