


TOWN OF LEXINGTON - BOARD OF PUBLIC WORKS
SEWER DIVISION

Date: 4/25/24

SKETCH OF SERVICE HERE
410 WOBURN ST.

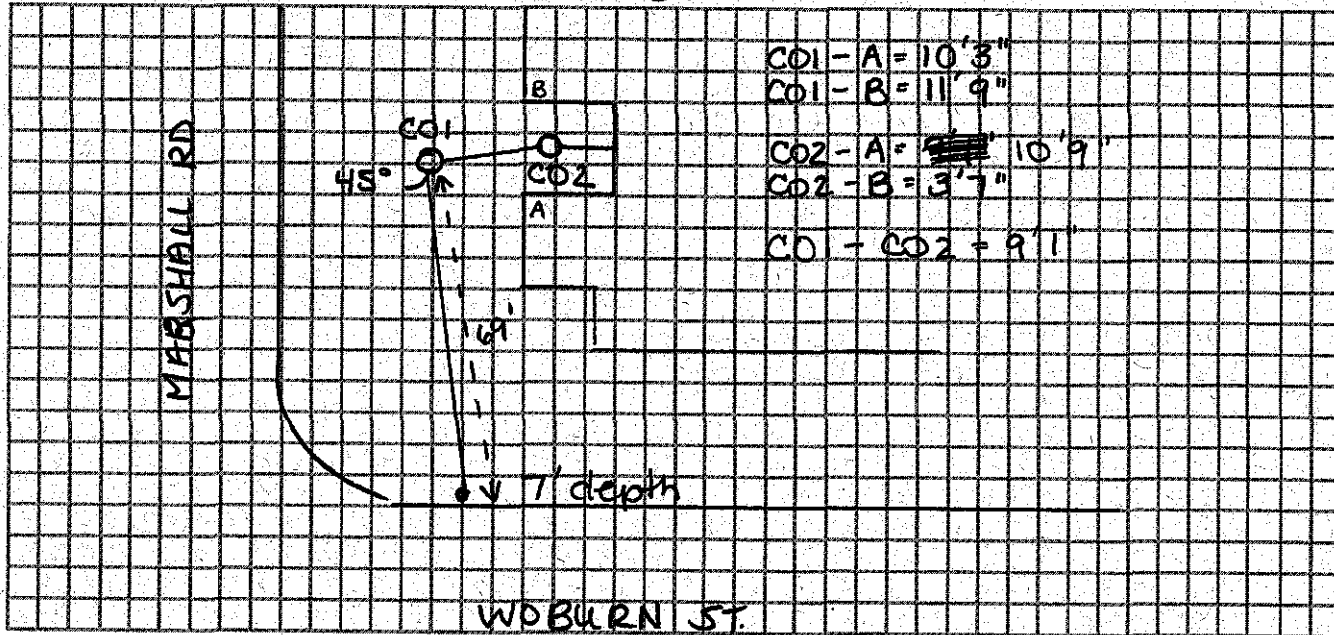

Connection made in:

Street.

Work completed:

Remarks: Installed by UTICON

