

Name Donald Cruwys

Service No. 193

Address 45 Woburn Street

45 Woburn Street

Location

Kind of Pipe Russell Sibley

Size 6"

Size of Main 8"

Reading Street - New Service W.O. #9386 Permit #167

Location MAY 17 1965


Date	Material	Amount	Total	Date	Amount
1-13-65	Labor	99.58		11-30-64	Deposit 100.00
	10% O.H.	9.96	109.54	1-18-65	Paid by W.H.C. 1964 50.00
	20' 6" Transite pipe @.82		16.40	6-24-65	Paid 13.44
	3 hrs. Town Shovel @6.50		19.50		163.44
	2 hrs. Town Truck @3.00		6.00		
	12 x 3 Patch		12.00		
			163.44		
3-8-65	13' 6" Transite pipe				
				6-8-73	Sludge
				5/27 76	Bill sent 130.44 solids

DATE _____

TOWN OF LEXINGTON — BOARD OF PUBLIC WORKS
SEWER DIVISION

Sketch of Service Here

45

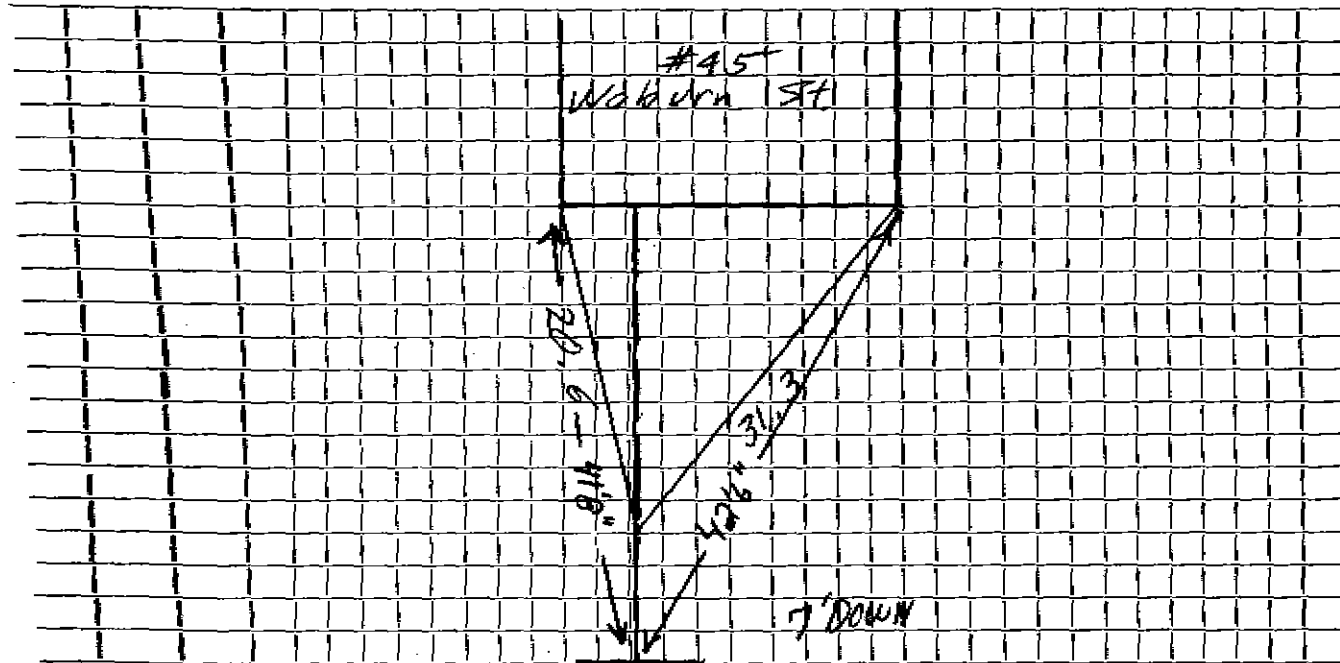

Connection made in _____ Street. Work completed _____

Remarks: _____
