

Name Kelley, J. W.

Service No. 9 / 1736

Address

Woburn St., Lexington

47 Woburn Street

Location

Same

Kind of Pipe

Size 6"

Size of Main 8"

Revised Estimate - New Service

Location

Date	Material	Amount	Total	Date	Amount
1936					
June 9	14 hrs. labor @ 60¢	8 70		June 11, 1936	Deposited
June 9-21-36	56 " " @ 55¢	30 80	39 50		
10%	Ovhd. on labor		3 95		
	22' 6" Sewer Pipe @ 16¢	3 52			
	Joint. Comp.	68			
	2 hrs. Truck. @ \$.75	1 50			
	6 " Comp. @ 3.00	18 00	23 70		
	Trench Repairs		2 85		
			70 00		
	Labor				

TOWN OF LEXINGTON—BOARD OF PUBLIC WORKS

SEWER DIVISION

DATE May 29, 1936.

NO. _____

The undersigned applies for the construction of a particular sewer connecting No. 46 Woburn St.
Street and hereby agrees to comply with the Rules and Regulations governing the construction and use of Particular
Sewers, as now or at any future time established by the Board of Selectmen.


Am't. of Estimate \$ 70⁰⁰

Am't. Paid \$ _____

Owner To Dig Own Trench

J. W. Kealey Owner

Sketch of Service Here

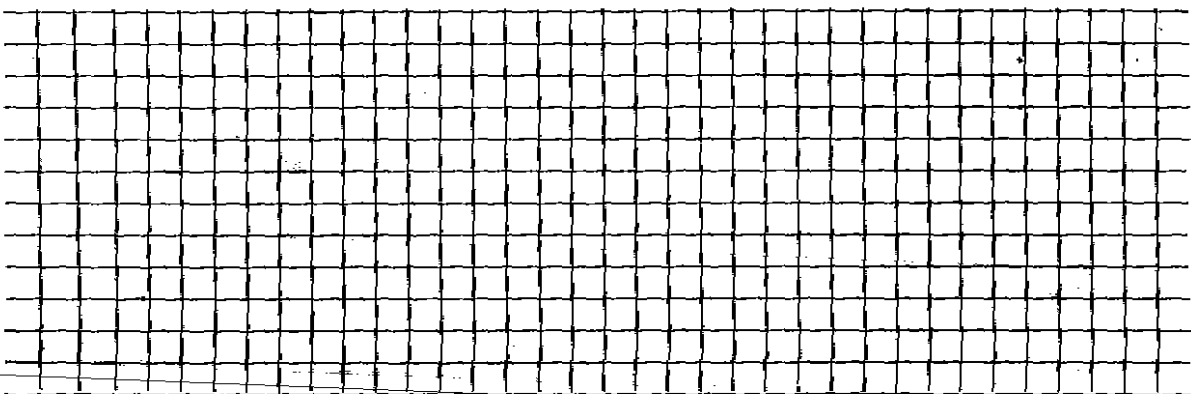

Connection made in _____ Street. Work completed _____ 19

Remarks: