

Name Mrs. Sarah Spencer

Service No. 38-170

Address 48 Woburn Street

48 Woburn Street Location 48 Woburn St

Kind of Pipe

Size 6"

Size of Main 8"

Repair—Renewal—New Service

Location

Date	Material	Amount	Total	Date	Amount
12/7/40	11 hrs. @.55	6 05		December 22, 1940	65.00
12-21-40	47 hrs. @.60	28 20	34 25		
	42' 6" Sewer Pipe	@.16	6 72		
	Joint Compound		2 52		
	Compressor, 4 hrs.	@3.00	12 00	1-17-41	14 10
	Trucking, 2 hrs.	@.75	1 50		
	Patching, 15' x 2'		12 00		
	10% Overhead		3 42		
			<u>\$72 41</u>		
	Charge \$65.00				
	Labor				

TOWN OF LEXINGTON—BOARD OF PUBLIC WORKS

SEWER DIVISION

DATE Nov. 12, 1940.

NO. _____

The undersigned applies for the construction of a particular sewer connecting No. 48 Hoburn St. Street and hereby agrees to comply with the Rules and Regulations governing the construction and use of Particular Sewers, as now or at any future time established by the Board of Selectmen.


Am't. of Estimate \$ 65.00 10.00 for water —

Am't. Paid \$ _____

Sarah Spencer Owner

Sketch of Service Here

48

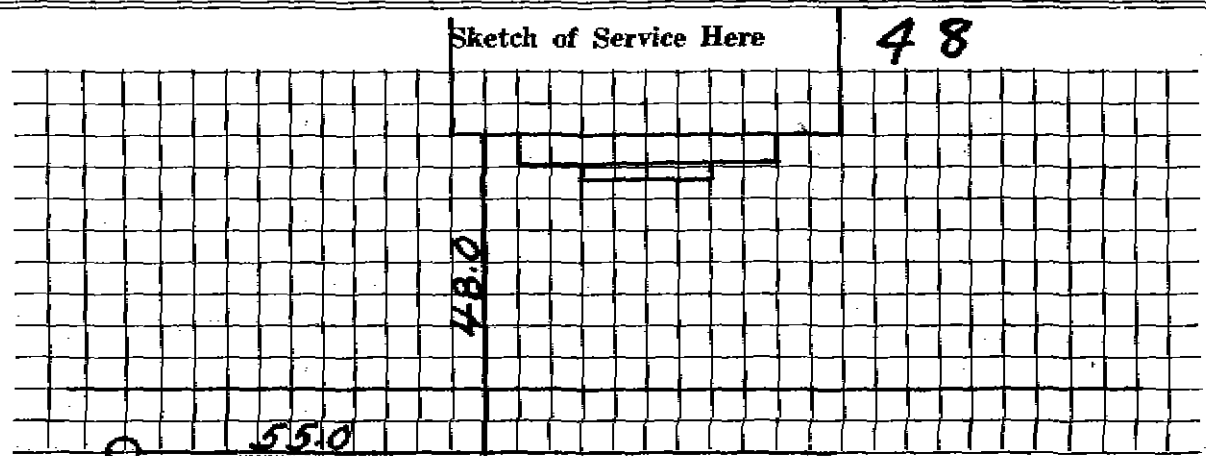

Connection made in _____ Street. Work completed _____ 19____

Remarks: