


DATE 6/7/89

TOWN OF LEXINGTON — BOARD OF PUBLIC WORKS
SEWER DIVISION

Sketch of Service Here **480**

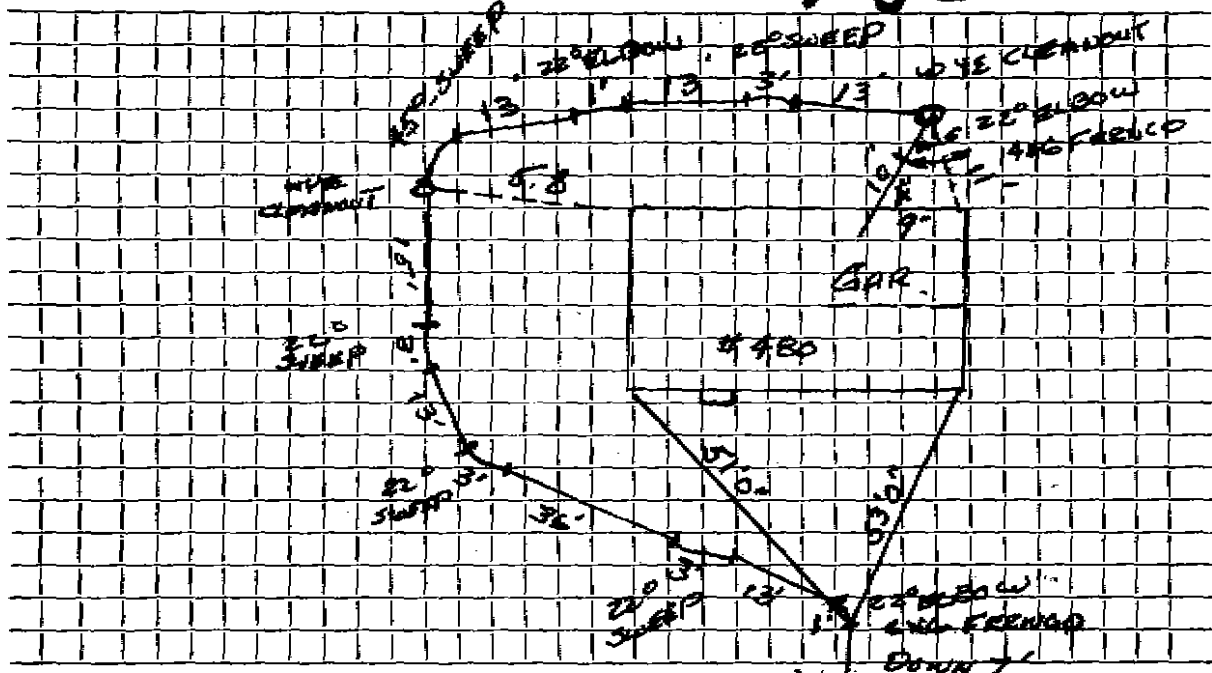

Connection made in WOBURN ST. Street. Work completed

Remarks:
.....
.....