


DATE _____

TOWN OF LEXINGTON — BOARD OF PUBLIC WORKS

SEWER DIVISION

Sketch of Service Here **509**

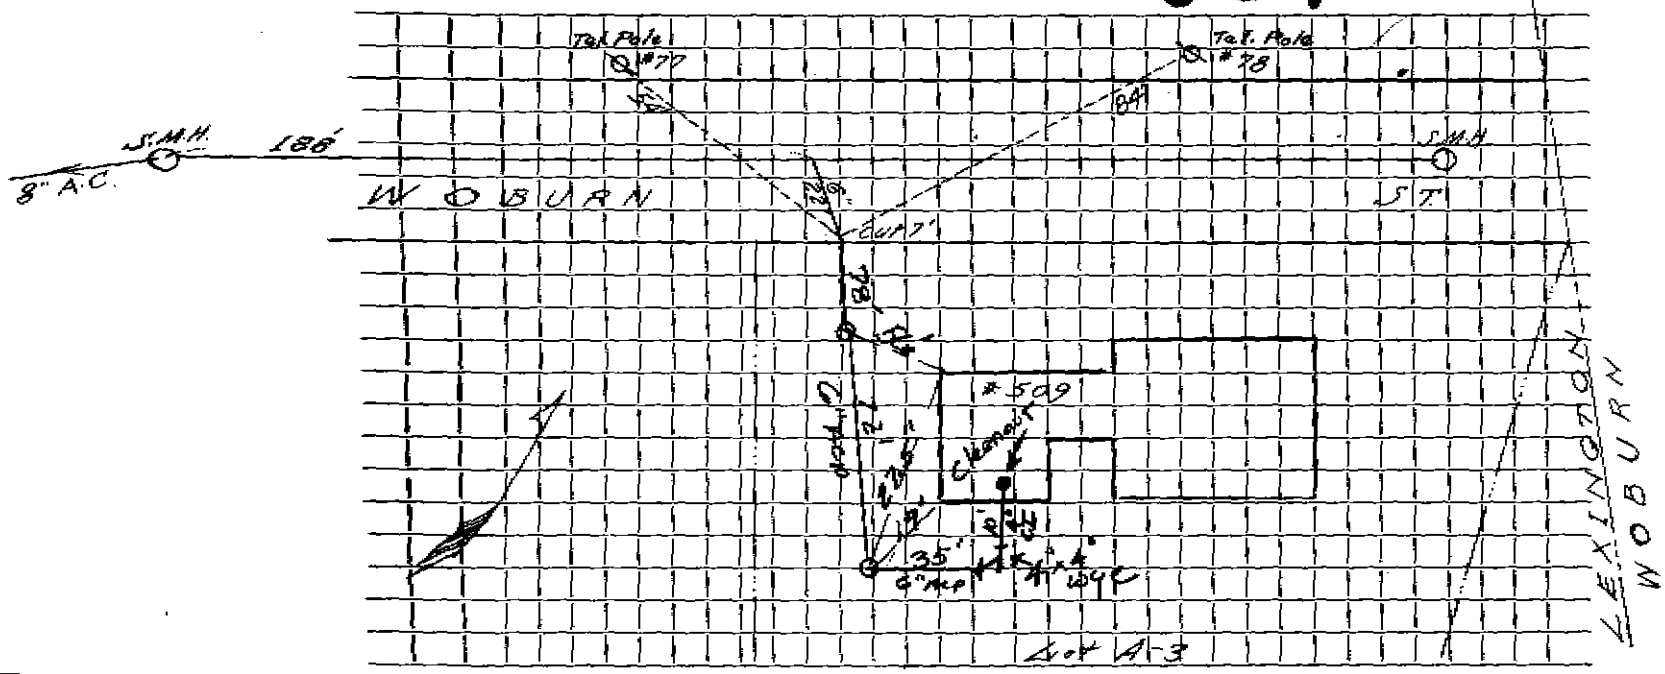

Connection made in WOBURN Street. Work completed

Remarks: