

Name John F. McDonough

Service No. 588

Address 54 Weburn Street

54 Weburn Street Location 54 Weburn St

Kind of Pipe

Size 6"

Size of Main 8"

~~REPAIR~~ - New Service

Location

Date	Material	Amount	Total	Date	Amount
June 21 Jan 7/20/37	17 hrs @ 50¢	8 50		Jan 11/29/37	71 00
	48 " 55¢	26 40			
	43 " 60¢	25 80			
	12 " 70¢	8 40	69 10		
	Overhead		6 91		
	32' 6" Sewer Pipe @ 23¢		7 28		
	1 6" 1/8 Bend		1 00		
	Jointing Compound		1 50		
	2 hrs trucking @ 75¢		1 50		
	6 " compressor @ 5.00		18 00		
			195 47		
	Flat Rate:		470 00		
	Labor				

TOWN OF LEXINGTON—BOARD OF PUBLIC WORKS  
SEWER DIVISION

DATE June 11, 1937

NO. \_\_\_\_\_

The undersigned applies for the construction of a particular sewer connecting No. 54 Auburn St. Street and hereby agrees to comply with the Rules and Regulations governing the construction and use of Particular Sewers, as now or at any future time established by the Board of Selectmen.


Am't. of Estimate \$ 70<sup>00</sup>

Am't. Paid \$ \_\_\_\_\_

John T. McDonough Owner

Sketch of Service Here

54

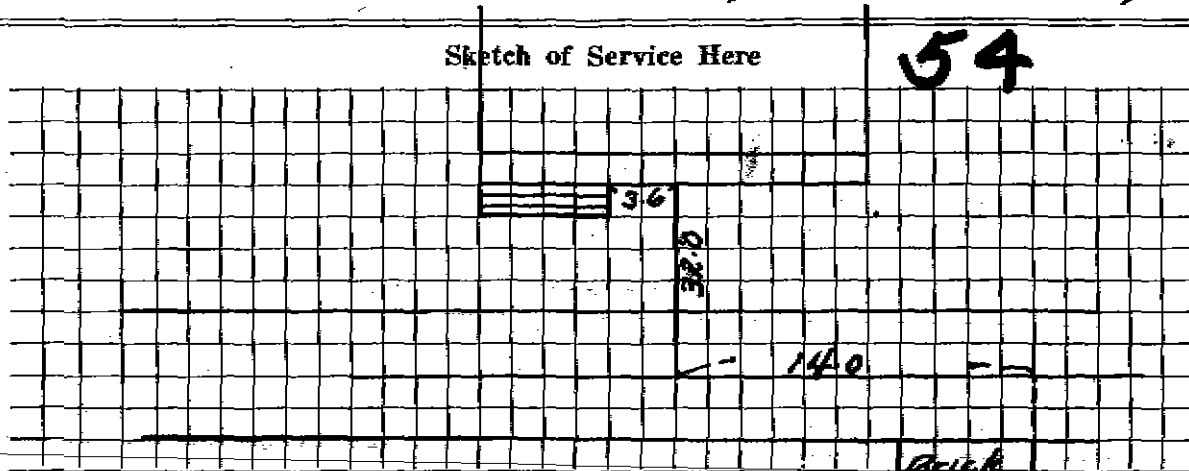

Connection made in \_\_\_\_\_ Street.

Back  
Store  
Work completed \_\_\_\_\_

19

Remarks: