

Name Carlton Higgins

Service No. 127

Address 57 Woburn Street

57 Woburn Street

Location

Kind of Pipe

Size **6"**

Size of Main **8"**

~~Renewal~~ ~~Work~~

W.O. # 2777

Location FEB 10 1975

Date	Material	Amount	Total	Date	Amount
11-26-74	Labor	22 99			
11-27-74	Labor	46 18		11-26-74	Labor 68 97
12-5-74	Labor	25 40		11-27-74	Labor 103 48
		94 57			15' Transite Pipe (6") 1.20 18 60
	10% O.H.	9 46	104 03	1	6"x8" CI Saddle 13 96
28'	6" Transite Pipe	1 24	34 72	2	1'x6" Nip @ 1.60 3 20
1	4" Donut		3 05	1	6"x9" EI 5 07
2	Hrs. Trucking	3 00	6 00	1	11'x14" EI 3 94
3	Hrs. Trucking	1 50	4 50	1/8	Bag Cement @ 2.10 26
2	Hrs. Town Shovel	6 50	13 00	1	Ton Cold Patch 12 20
1	Hr. Compressor	5 00	5 00	2	Hrs. Trucking @ 3.00 6 00
1	Patch 11' x 18'		176 00	2	Hrs. Trucking @ 1.50 3 00
			\$346 30	3	Hrs. Town Shovel @ 6.50 19 50
					<u>\$258 18</u>
				11-26-74	Deposit 300.00
				5-4-75	Paid 46.30
					<u>346.30</u>


TOWN OF LEXINGTON — BOARD OF PUBLIC WORKS

SEWER DIVISION

DATE _____

Sketch of Service Here

57

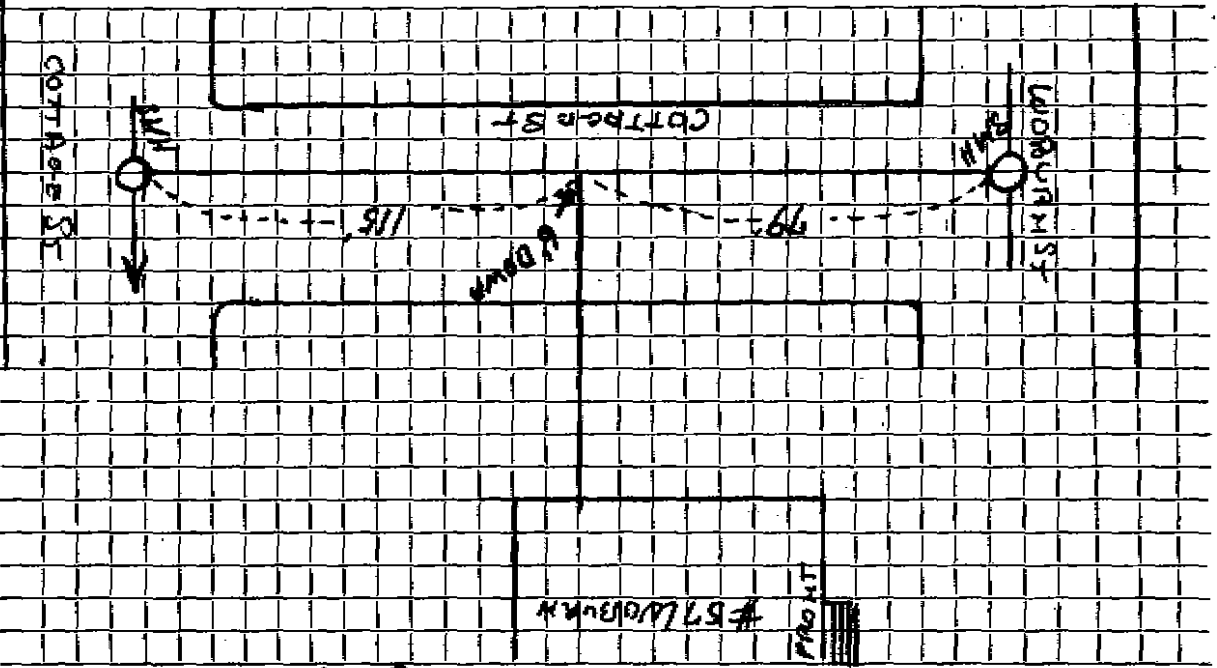

Connection made in COTTAGE ST Street.

Work completed

Remarks: