


DATE 9/16/19

TOWN OF LEXINGTON — BOARD OF PUBLIC WORKS
SEWER DIVISION

Sketch of Service Here

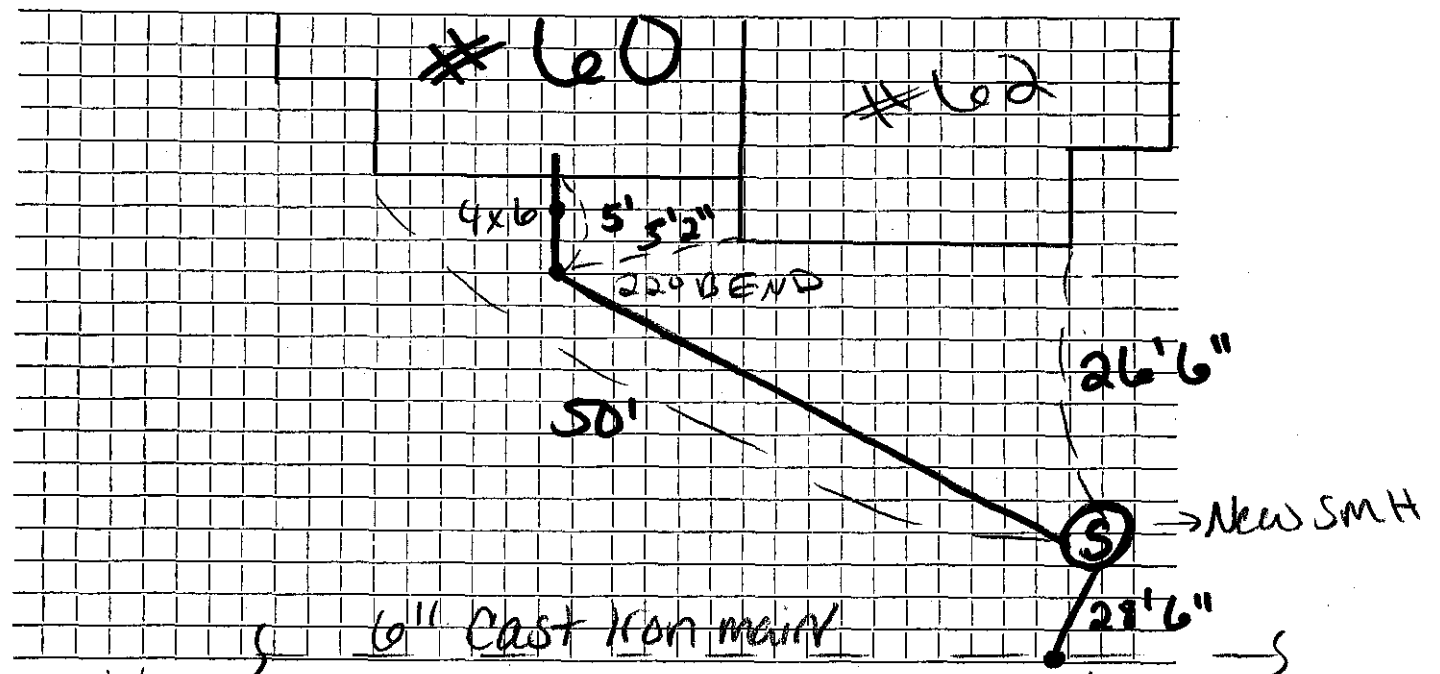

Connection made in Woburn Street.

Work completed 6x6" wye 8' down.

Remarks:

.....

.....