

Name JM McLaughlin
 Address 62 Woburn St

Service No.

Location

Kind of Pipe SDR35 PVC

Size 6"

Size of Main

Repair—Renewal New Service


Location

Date	Material	Amount	Total	Date	Amount
9/16/19	SMH				
	6" PVC	28'			
	6" 11° bend				
	6" PVC	9'			
	6x6" Wye				
	4x6"				
	6" PVC	27'			
	6" cleanout				
	6" PVC	24'6"			
	6" cleanout				
	4" tie in				
	to existing clay service				

DATE 9/16/19

TOWN OF LEXINGTON — BOARD OF PUBLIC WORKS
SEWER DIVISION

Sketch of Service Here

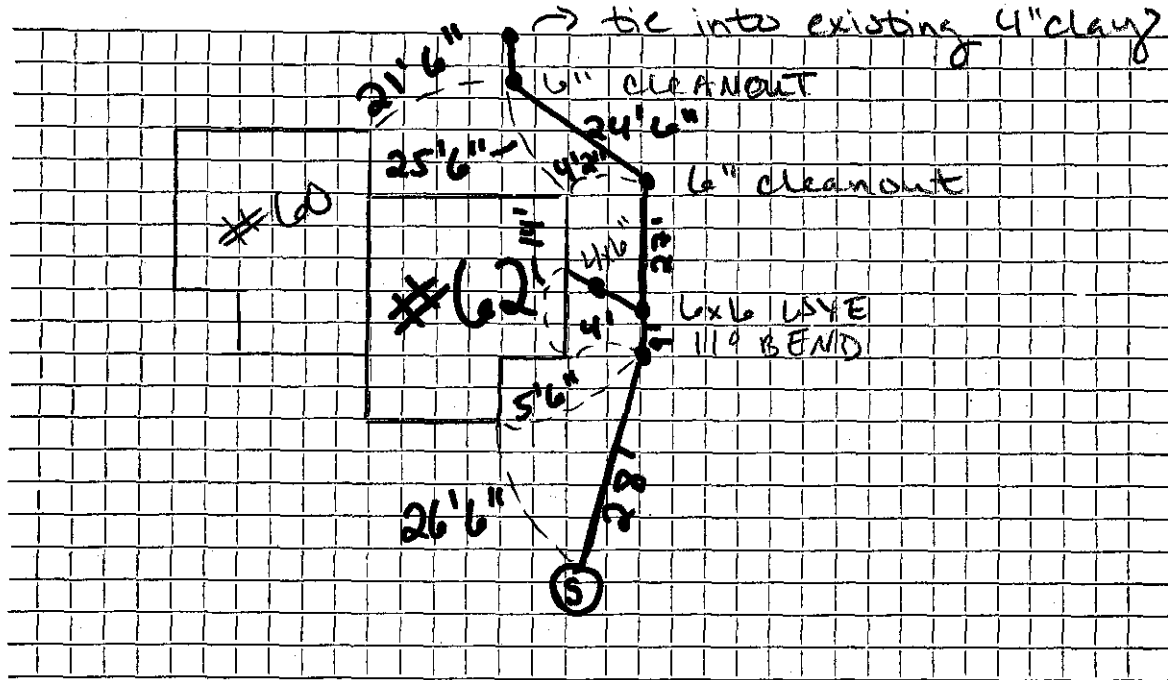

service for
Vine St house
behind.

Connection made in Woburn St Street. Work completed

Remarks: