

18 2/2 1.50 27.50
34.50

TOWN OF LEXINGTON—BOARD OF PUBLIC WORKS

SEWER DIVISION

DATE June 24, 1935

NO. _____

The undersigned applies for the construction of a particular sewer connecting No. 69 Woburn St. Street and hereby agrees to comply with the Rules and Regulations governing the construction and use of Particular Sewers, as now or at any future time established by the Board of Selectmen.

Am't. of Estimate \$ 34.50


Am't. Paid \$ _____

Francis A. Polver Owner

910.00 deposited

Sketch of Service Here

69

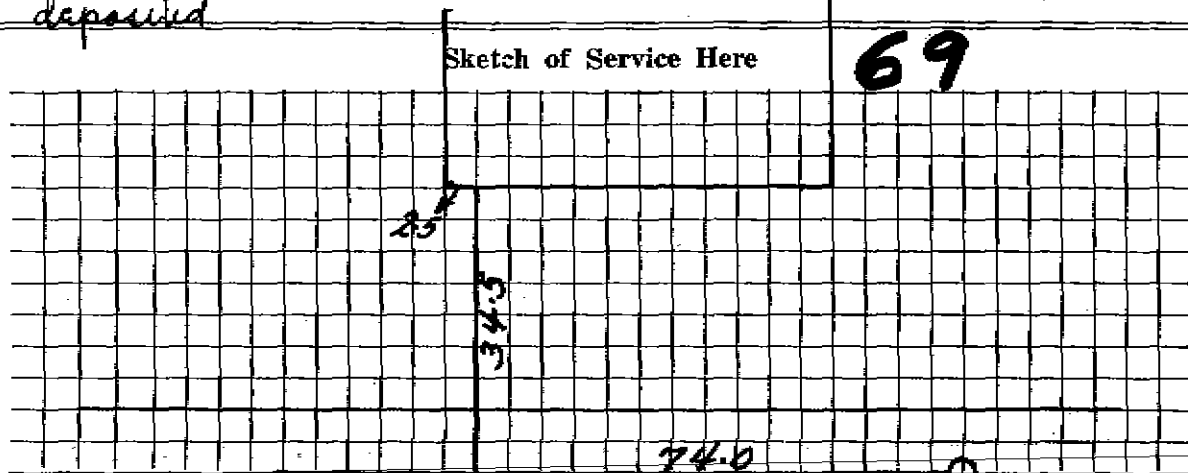

Connection made in _____ Street.

Work completed _____ 19

Remarks: