

Name George Shannon

Service No. 48

Address 70 Woburn Street

70 Woburn Street

Location

Kind of Pipe

Size 6"

Size of Main 8"

~~XXXXXXXXXXXX~~ New ServiceLocation *Comm 7-6-57*

Date	Material	Amount	Total	Date	Amount	
5-13-59	Labor	77.33		4-28-59	Deposit	200.00
5-14-59	Labor	66.61	143.94	7-6-59	Paid by WMA 76	20.75
	10% O.H.	14.39	158.33	7-14-59	Paid	36.18
	58' 6" Transite pipe @.70		40.60			256.93
	2' 6" Clay Pipe @.435		.87			
	1 6" Clay Elbow		1.88			
	4 hrs. Town Shovel @6.50		26.00			
	3 hrs. Trucking @.75		2.25			
	1 hr. Rodgers Trailer @3.00		3.00			
	1 hr. Trucking @3.00		3.00			
	21 x 3 Patch		21.00			
			256.93			
	Labor			4/2/71	Roots	
				5/3	Pipe appeared to be broken	
					Bill sent 7-6-57 36.18	

TOWN OF LEXINGTON—DEPT. OF PUBLIC WORKS
SEWER DIVISION

DATE.....

NO.


The undersigned applies for the construction of a particular sewer connecting No.....
Street and hereby agrees to comply with the Rules and Regulations governing the construction and use of Particular
Sewers, as now or at any future time established by the Board of Selectmen.

Am't of estimate \$.

Am't Paid \$.

..... Owner

Sketch of Service Here **70**

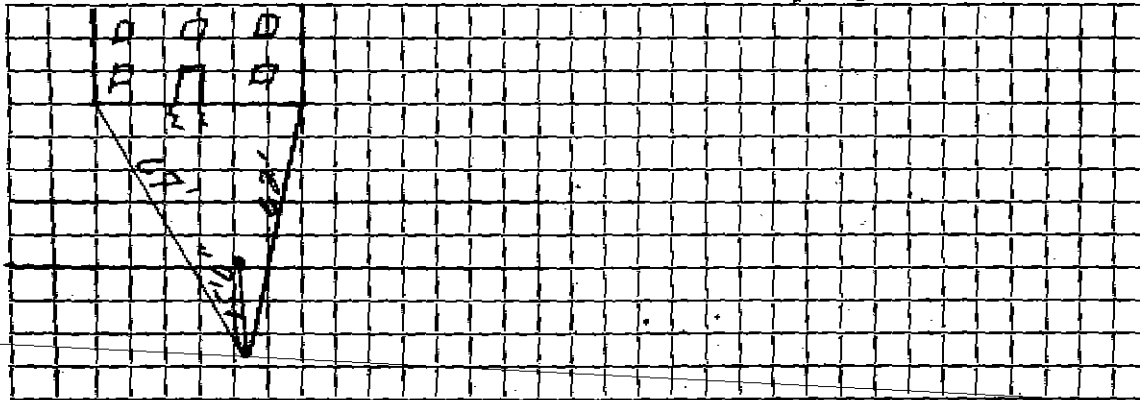

Connection made in *2'* chimney *6' deep* Street.

Work completed.....19...

Remarks: *5/5/01*
S