

Name *Lester Savage*

Service No. 41

Address 71 Woburn Street

71 Woburn Street

Location

Kind of Pipe

Size *6"*Size of Main *8"*~~Repair - Renewal - New Service~~ WO #4579

Location


Date	Material	Amount	Total	Date	Amount	
6/17/76	labor	110.94		<i>6/19/76</i>	<i>Deposit</i>	<i>350.00</i>
6/18/76	labor	39.96	150.90	<i>8/16/76</i>	<i>Refund</i>	<i>132.03</i>
	10%OH	15.09	165.99			<i>217.97</i>
2'	6" Transite Pipe @ 1.48		2.96		OUTSIDE	
1	22½ Bend		9.26	6/17/76	labor	136.89
1	22½ Bend		6.76	18'	6" Transite Pipe @ 1.48	21.90
1	11½ Collar El		3.84	1	6" X 6" Elbow	5.48
1	12" X 6" nipple		2.44	1	2' X 6" Nipple	5.39
1½	yds. loam @ 4.50		6.75	1	6" X 8" Saddle	14.70
3	lbs. seed @ .39		1.17	1½	hr. truck @ 3.00	4.50
2	hr. truck @ 3.00		6.00	2	hr. compressor @ 5.00	10.00
1½	hr. shovel @ 6.50		9.75	3	hr. shovel @ 6.50	19.50
1	4" to 6" Gasket		3.05		Patch 8' X 17'	97.32
			217.97			315.68

DATE _____

TOWN OF LEXINGTON — BOARD OF PUBLIC WORKS
SEWER DIVISION

Sketch of Service Here

71

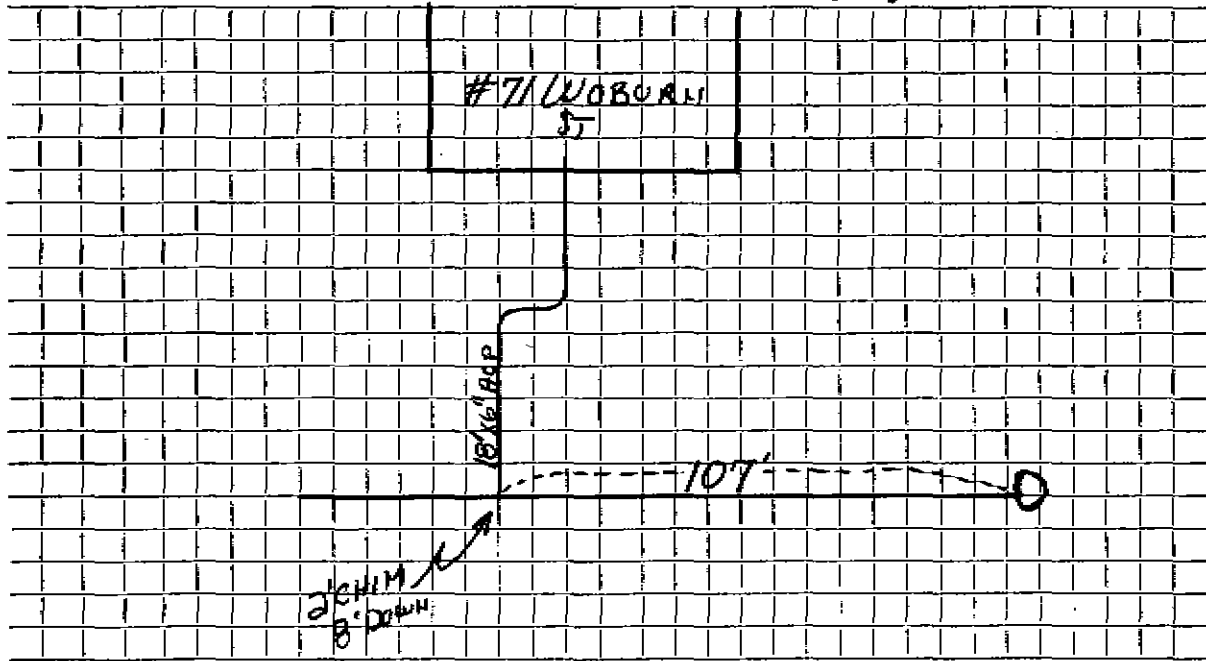

Connection made in _____ Street. Work completed _____

Remarks: _____
