

Name James Keefe

Service No. 7 1003

Address 93 Woburn Street

Lexington, Mass. 93 Woburn ST. Location 93 Woburn Street

Kind of Pipe

Size 6"

Size of Main 8"

~~Repair~~ ~~Renewal~~ New Service

Location

Date	Material	Amount	Total	Date	Amount
May 10, '45	Labor	27 85	27 85	May 9' 45	70 00
	10% Overhead		2 79	May 14' 45	12 16
	20' - 6" Sewer Pipe @.22		4 40		
	10 - 4" Soil Pipe @.50		5 00		
	Joint Compound		1 32		
	Compressor 1 hr. @1.75		1 75		
	Trucking 1 hr. @.75		75		
	Patching 14 x 3		13 98		
			57 84		57 84
	<b>Labor</b>				

TOWN OF LEXINGTON—DEPT. OF PUBLIC WORKS  
SEWER DIVISION

DATE .....

NO. ....


The undersigned applies for the construction of a particular sewer connecting No. ....  
Street and hereby agrees to comply with the Rules and Regulations governing the construction and use of Particular  
Sewers, as now or at any future time established by the Board of Selectmen.

Am't of estimate \$.....

Am't Paid \$.....

..... Owner

Sketch of Service Here **93**

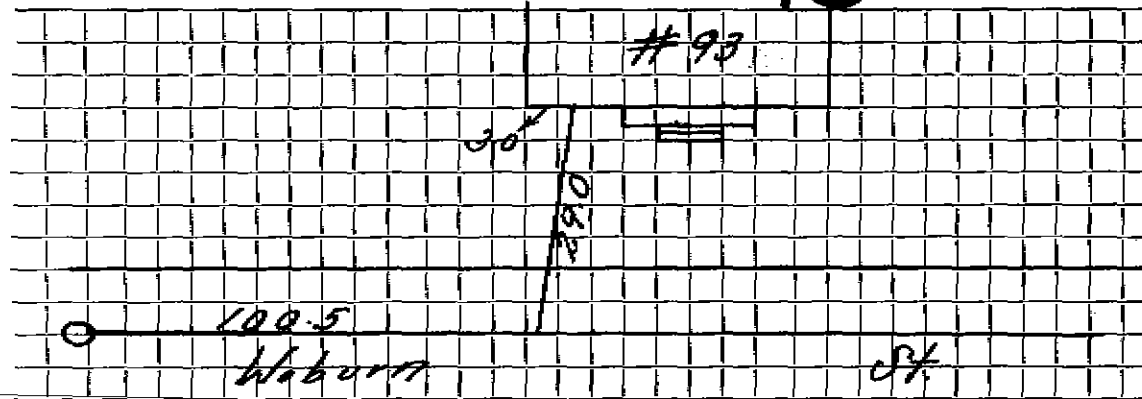

Connection made in ..... Street.

Work completed ..... 19..

Remarks: