




DATE \_\_\_\_\_

TOWN OF LEXINGTON — BOARD OF PUBLIC WORKS  
SEWER DIVISION

Sketch of Service Here **97**

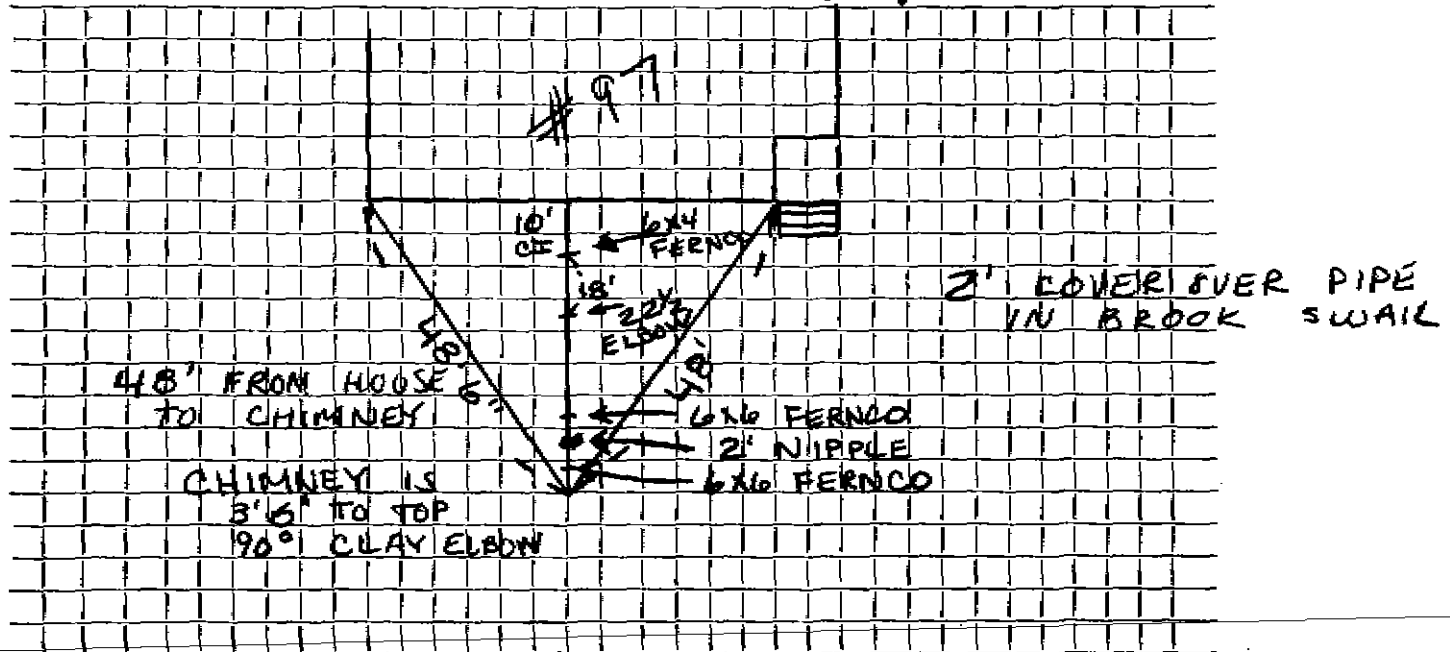

NOTE: NO OUTSIDE TIES

Connection made in WOBURN ST. Street. Work completed .....

Remarks: Original Service 6-4-95 .....