

Name James P. Crawford

Service No. 51

Address 394 Woburn Street *Change to 2 Marshall Rd.*

Lot 1 394 Woburn Street Location *Eng. Change plans*

Kind of Pipe

Size 6"

Size of Main 8"

~~Repair~~ ~~Renewal~~ New Service Baptiste #4494

Location FEB 27 1984


Date		Material	Amount	Total	Date	Amount
1970	46'	6" Transite pipe @9.00		414.00	11-24-80	414.00
24/84	30'	6" P.V.C.				
	10'	4" Cast Pipe				
	1	AC to PVC Adpt.				
		4" x 6" Donut				
					May 25 1996	Main blocked 25' up from MH # 158 - Grease

DATE _____

TOWN OF LEXINGTON — BOARD OF PUBLIC WORKS

SEWER DIVISION

Sketch of Service Here **394** RD.

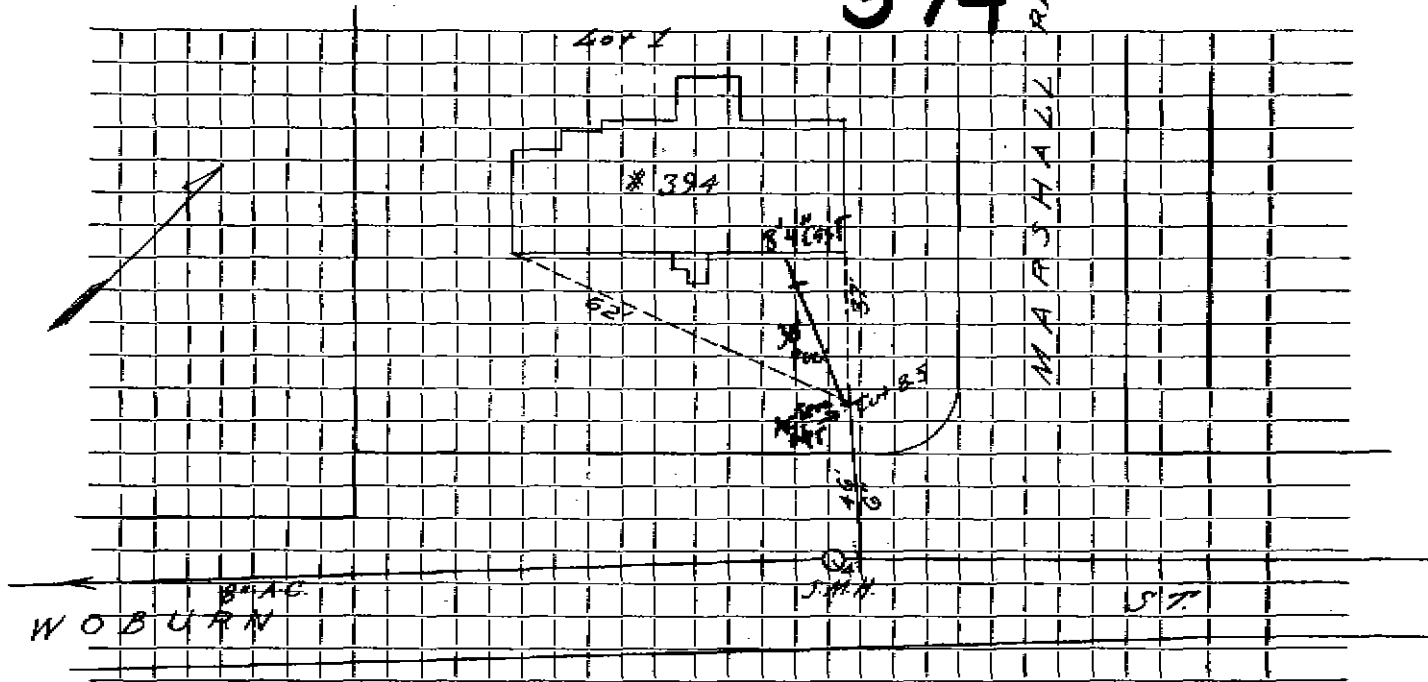

Connection made in Street. Work completed

Remarks:

.....

.....