




DATE 9/4/18

TOWN OF LEXINGTON — BOARD OF PUBLIC WORKS  
SEWER DIVISION

Sketch of Service Here

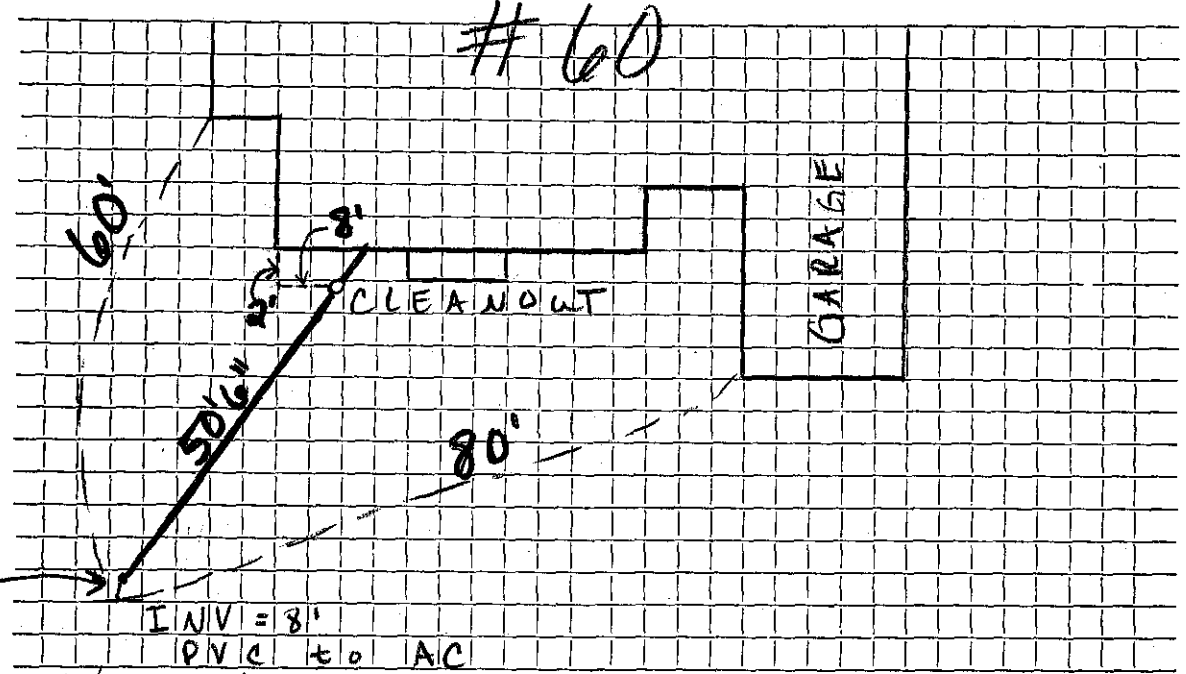

11 1/4°  
BEND

Connection made in Wood St Street. Work completed

Remarks: