


DATE _____

TOWN OF LEXINGTON — BOARD OF PUBLIC WORKS

SEWER DIVISION

102 Sketch of Service Here

S.I.S. FOR # 102

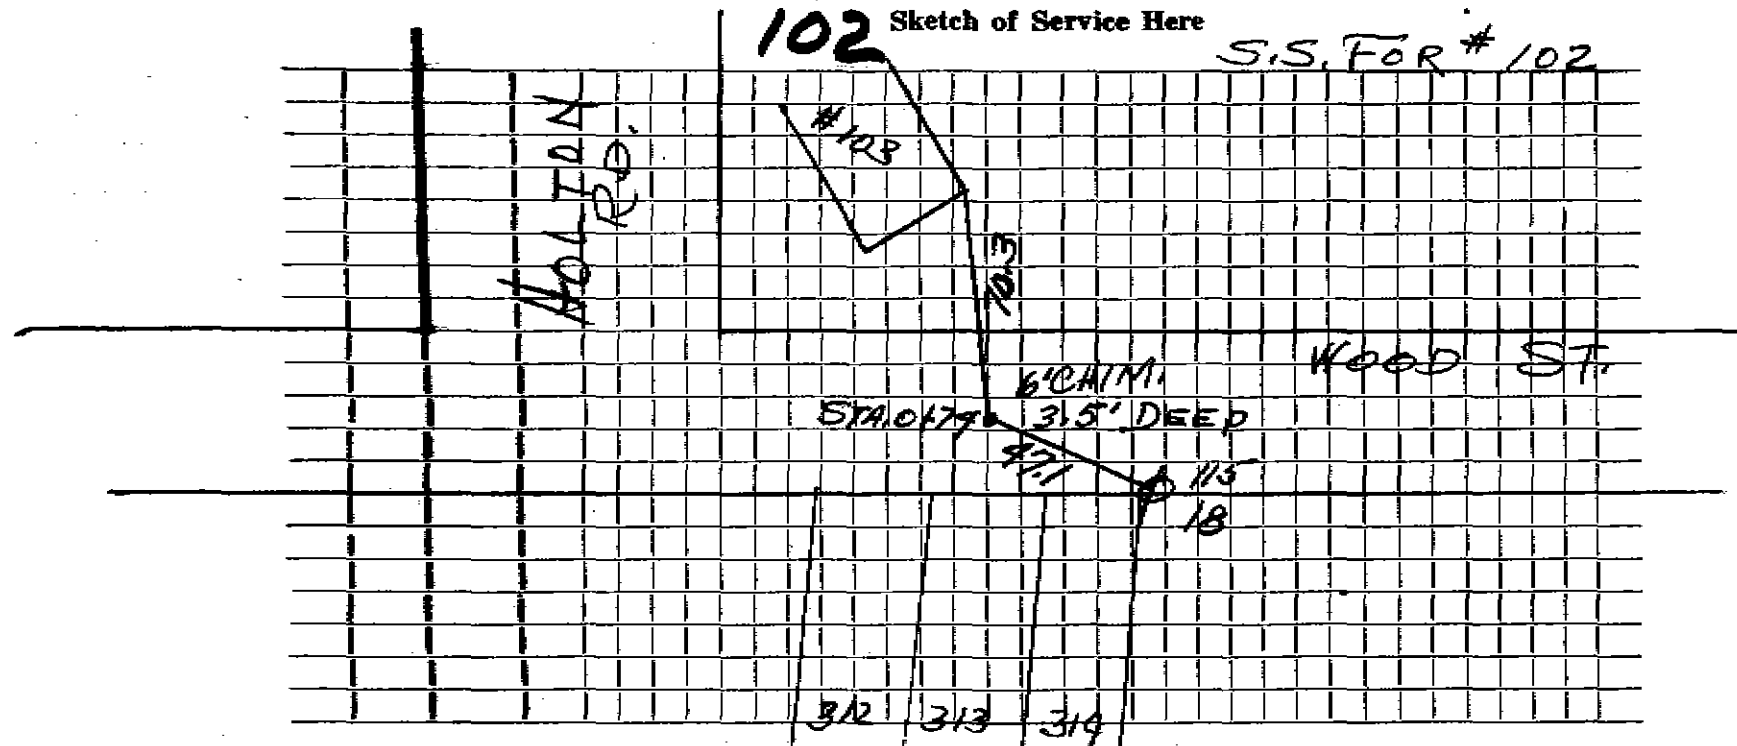

Connection made in Street. Work completed

Remarks: