

Name John Bresnahan

Service No. 23

Address 103 Wood Street

103 Wood Street

Location

Kind of Pipe

Size 6"

Size of Main 8"

~~XXXXXXXXXX~~ New Service W.O. #6419

Location


Road 5-9-60

Date	Material	Amount	Total	Date		Amount
4-13-60	Labor	44.52		4-4-60	Deposit	200.00
	10% O.H.	4.45	48.97	5-9-60	Retard	<del>76.44</del>
60'	6" Transite pipe @.78		46.80			123.56
1	6" Transite Elbow 45°		2.79		OUTSIDE	
2	hrs. Erie Shovel @6.50		13.00	6/26/78	labor	
1	hr. Trucking @3.00		3.00		1 6" X 6" 90° elbow	
9	x 3 Patch		9.00		1 6" X 8" cast iron saddle	
			123.56		2 3' X 6" nipples	
					1 5' X 6" nipples	
					1 6" X 6" nipples	
					1 6" cap	
					1 30° collar elbow	
					1 22½° collar elbow	
					1 hr. trucking	
					1½ hr. backhoe	

DATE \_\_\_\_\_

TOWN OF LEXINGTON — BOARD OF PUBLIC WORKS  
SEWER DIVISION

Sketch of Service Here

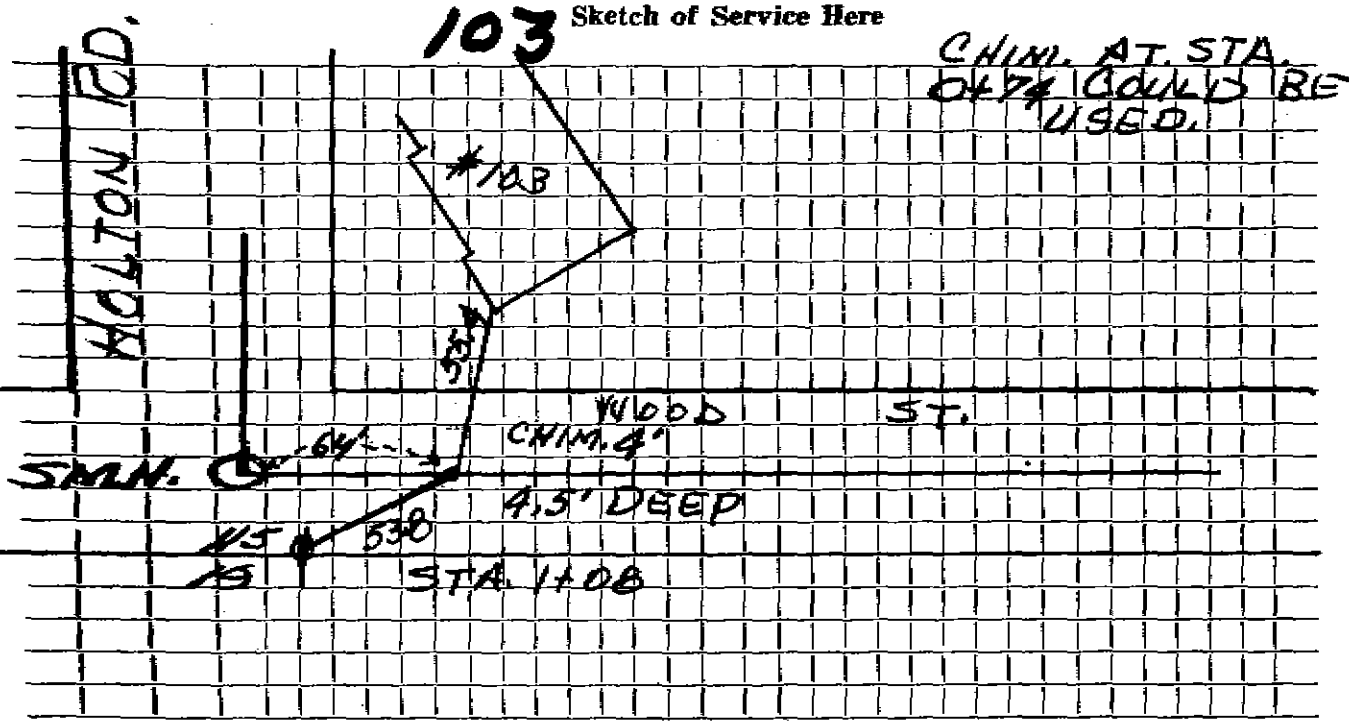

Connection made in \_\_\_\_\_ Street. Work completed \_\_\_\_\_

Remarks: \_\_\_\_\_  
\_\_\_\_\_  
\_\_\_\_\_