




DATE

TOWN OF LEXINGTON — BOARD OF PUBLIC WORKS

SEWER DIVISION

Sketch of Service Here 106  
302 310 311

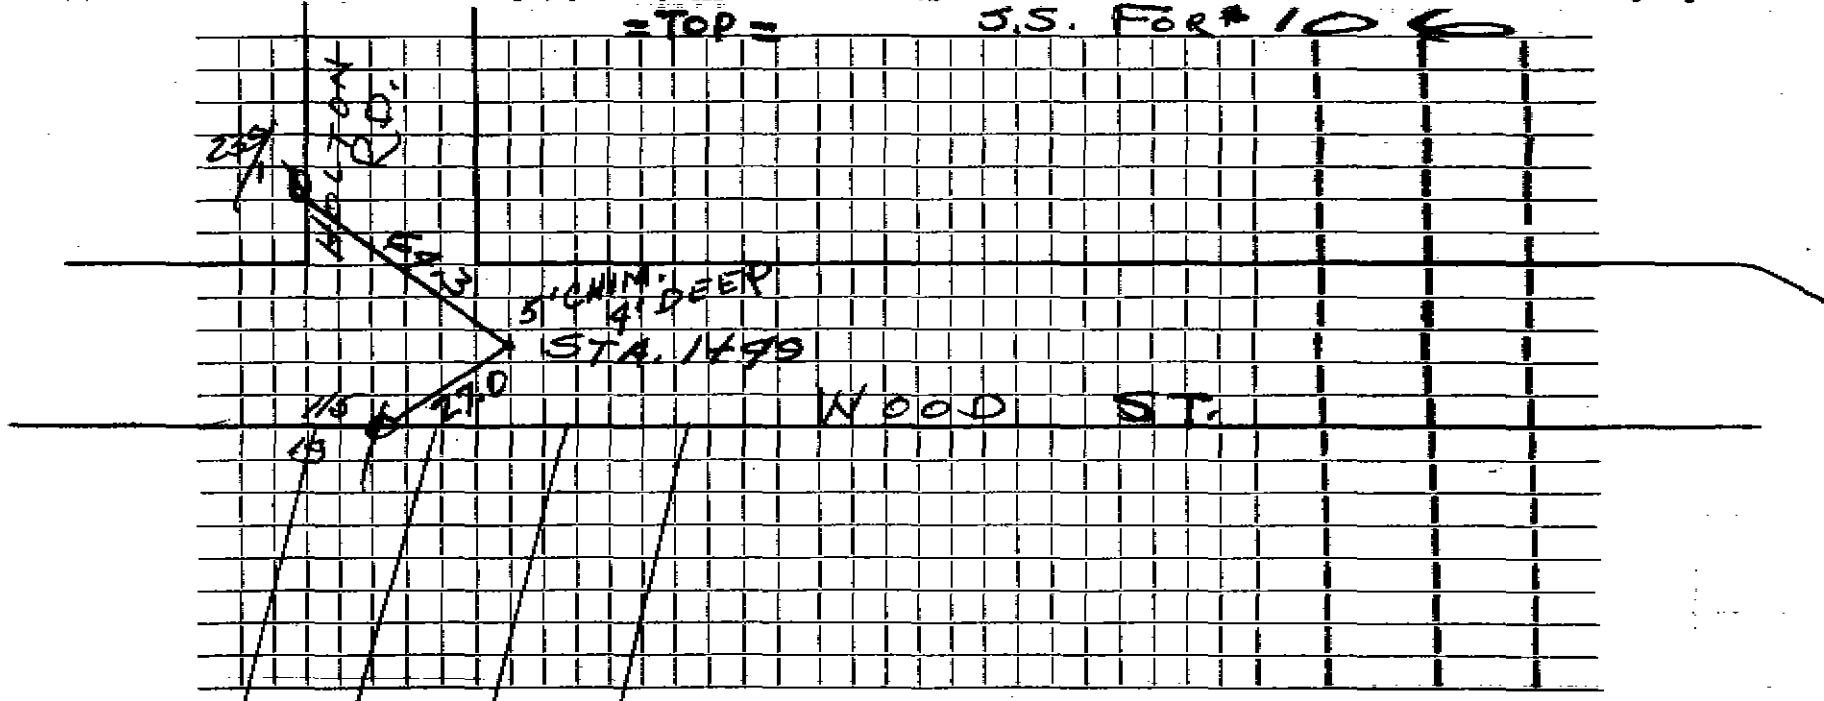

Work completed Street.

= TOP = J.S. FOR # 106

Connection made in

Remarks: