


DATE _____

TOWN OF LEXINGTON — BOARD OF PUBLIC WORKS
SEWER DIVISION

Sketch of Service Here

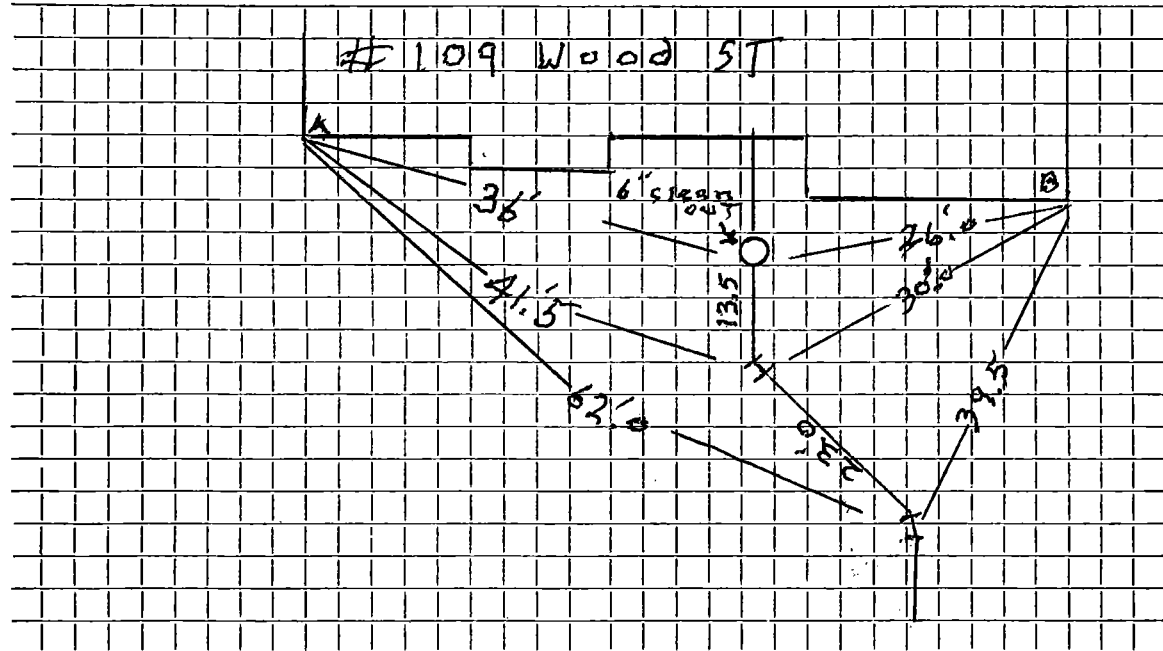

Connection made in Milton R.D. Street. Work completed July 2011

Remarks:

.....

.....