


DATE 4/9/2020

TOWN OF LEXINGTON — BOARD OF PUBLIC WORKS
SEWER DIVISION

Sketch of Service Here

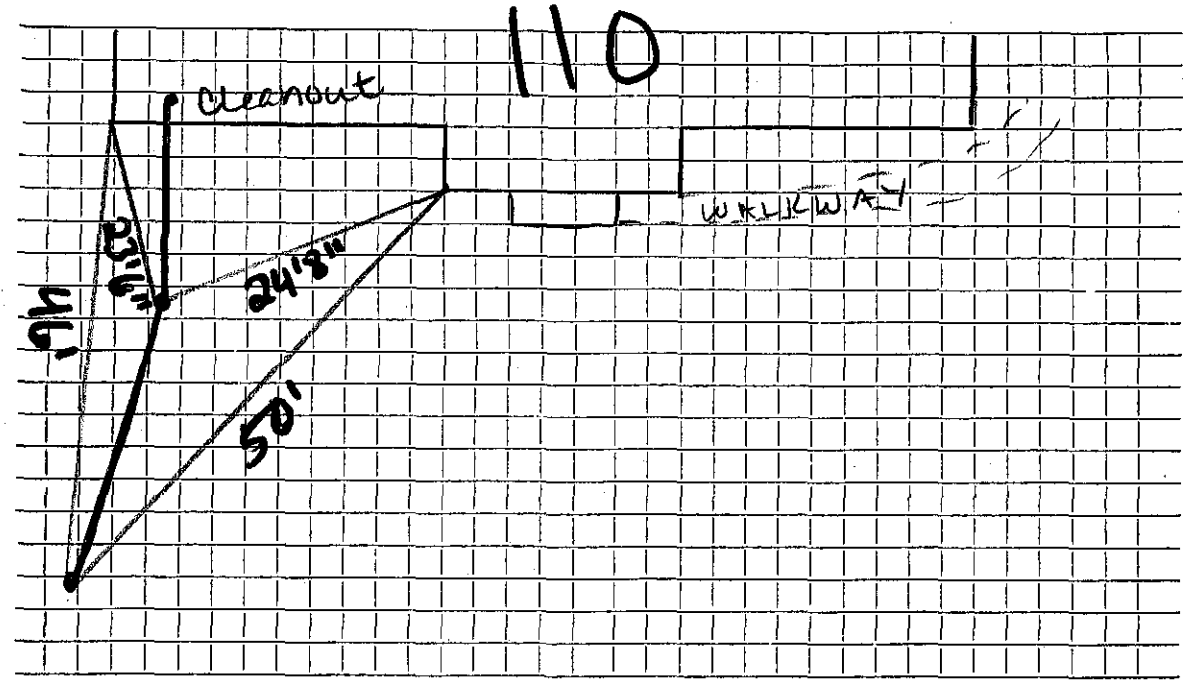

6" cleanout
& 45° bend

6" FernCo
PVC to AC

Connection made in WOOD Street. Work completed

Remarks:
..... plumbing inspector had them move cleanout inside
..... another cleanout at the 45° bend.