

Name Diamond West Realty Trust

Service No.

Address 114 Wood St.

114 Wood Street

Location

Kind of Pipe PVC

Size 6" x 4"

Size of Main 8"

Repair—Renewal—New Service

Cardillo #0099

Location

Date	Material	Amount	Total	Date	Amount
4/9/91	10 LF 4" PVC				
	38 LF 6" PVC				
	8' x 6" PVC SADDLE				
	6" 22° ELBOW				
	4' x 6" FERRECO				


TOWN OF LEXINGTON — BOARD OF PUBLIC WORKS

SEWER DIVISION

DATE _____

Sketch of Service Here

114

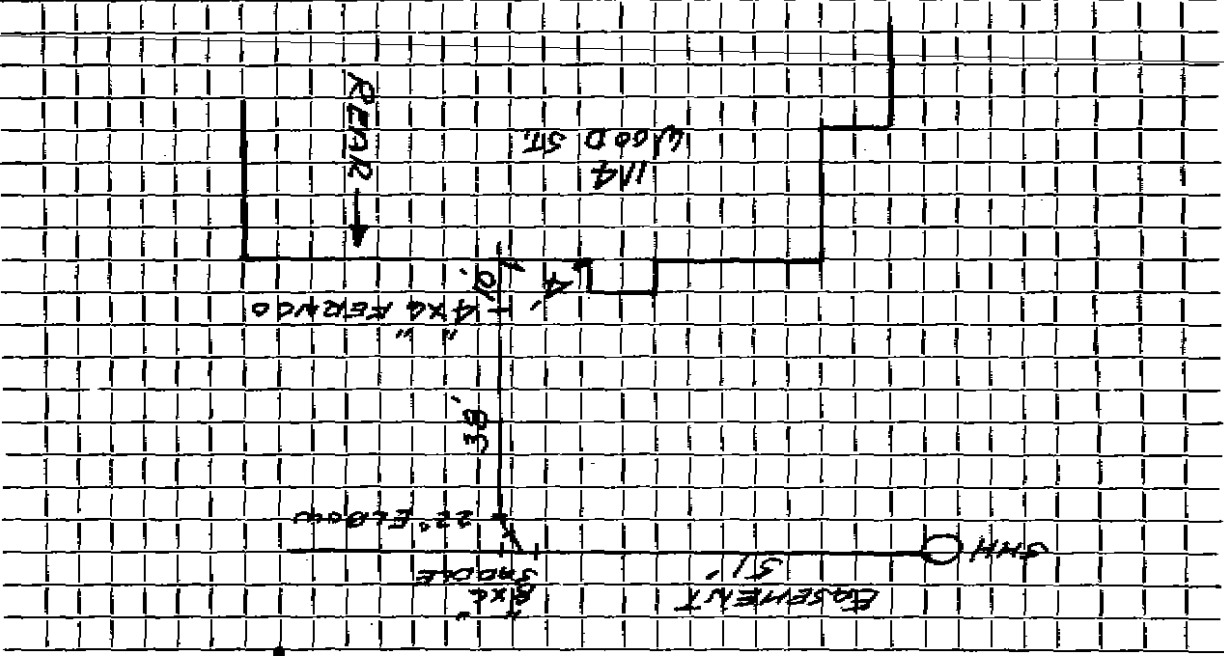

Street.

Work completed

4/9/91

Connection made in EASEMENT.

Remarks: SERV. @ REAR OF HSE.