


DATE Sept. 21, 2020

TOWN OF LEXINGTON — BOARD OF PUBLIC WORKS
SEWER DIVISION

Sketch of Service Here

137

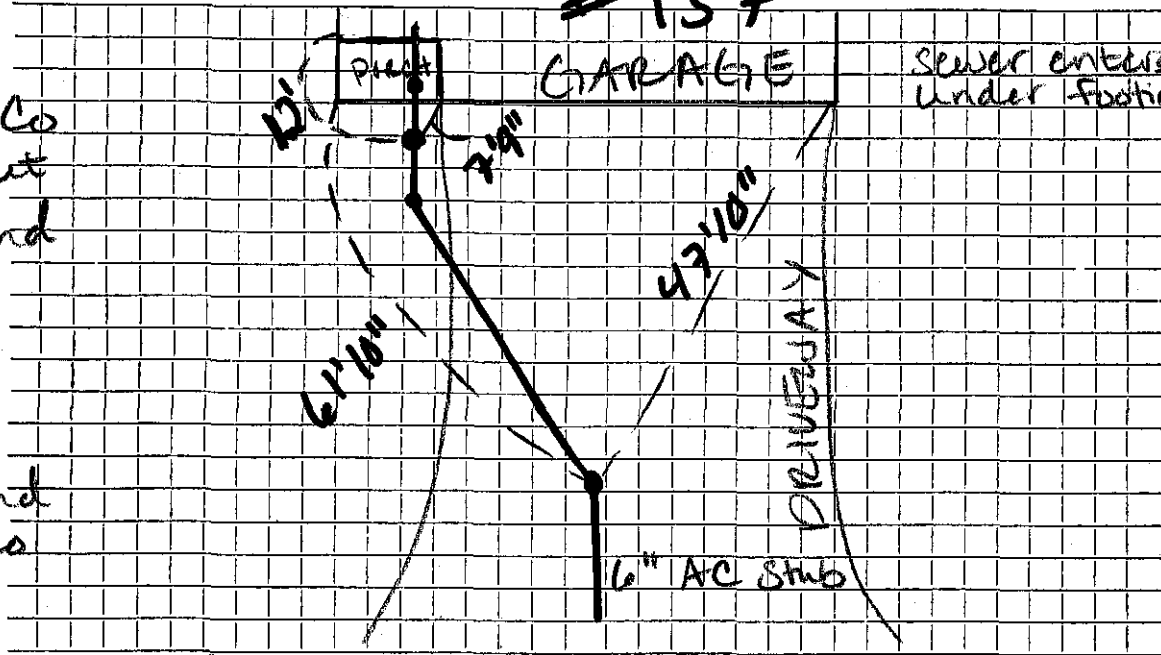

- 4x6" fernCo
- 6" Cleanout
- 6" 22° bend

- 6" 22° bend w/ fernCo

SEWER ENTERS UNDER FOOTING

6" PVC
42' RUN

Connection made in WOOD Street. Work completed

Remarks: 6' COVER