




DATE \_\_\_\_\_

**TOWN OF LEXINGTON — BOARD OF PUBLIC WORKS**  
**SEWER DIVISION**

Sketch of Service Here **139**

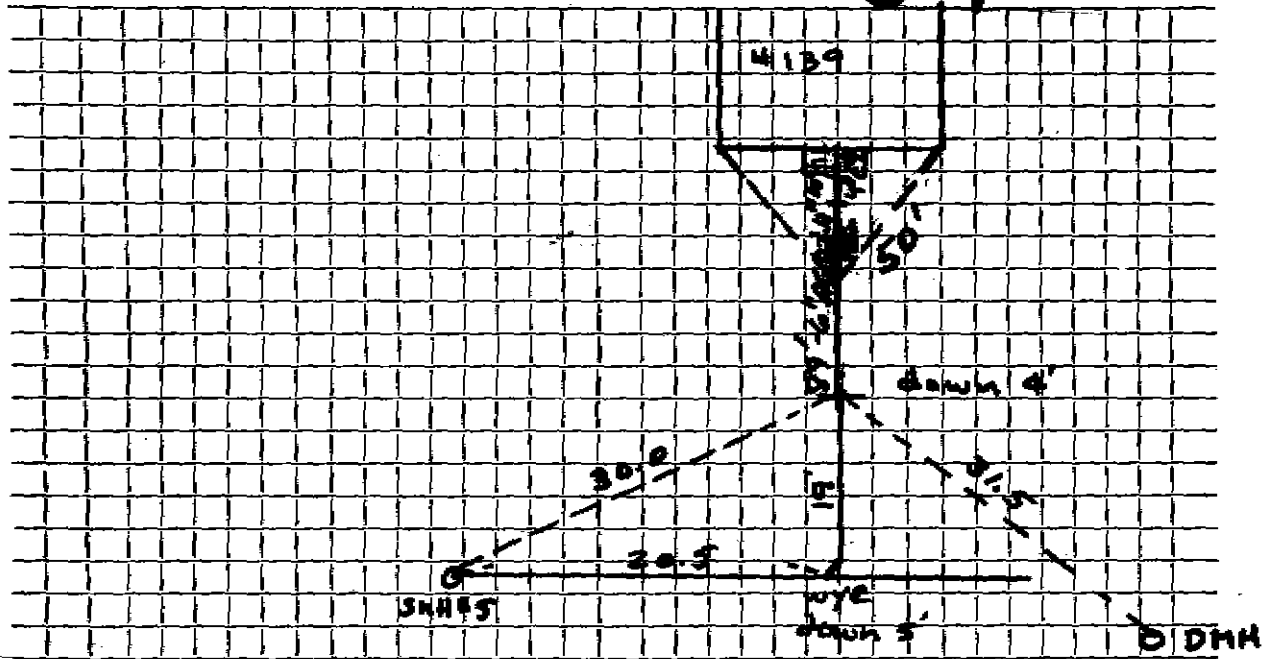

Connection made in Wood St. Street. Work completed .....

Remarks: .....