

Name A ngust Schumacher

Service No. 46

Address 148 Wood St.

148 Wood Street

Location

Kind of Pipe A.C.

Size 6"

Size of Main 8"

xBanters-Brentwood-New Service

Kirkland & Shaw #4483

Location OCT 31 1988

Date	Material	Amount	Total	Date	Amount
11-25-75	33'-6" ACP @	5.75	119.75	10-15-83	Deposit
10/7/83	38' 6" P.V.C.				


DATE 11-25-75

TOWN OF LEXINGTON — BOARD OF PUBLIC WORKS

SEWER DIVISION

Sketch of Service Here

148

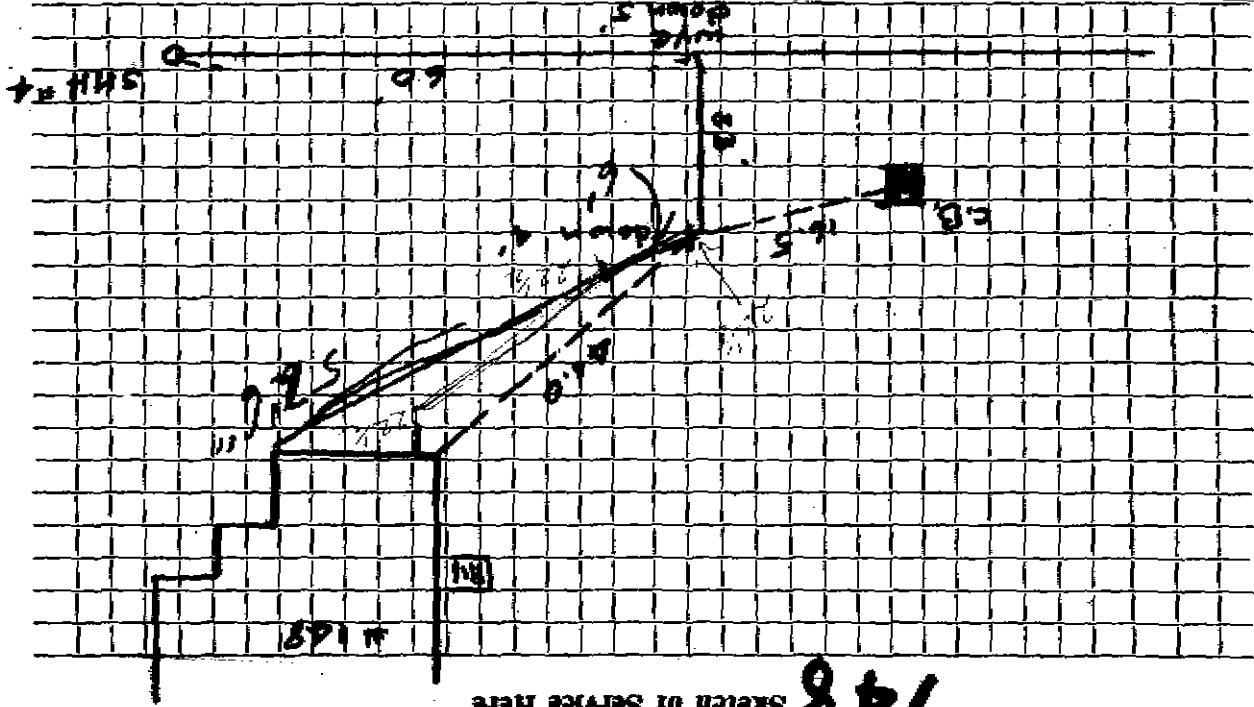

Work completed

Street

Wood St

Connection made in

Remarks: