

Name

Service No.

Address

148A Wood St

Location

Kind of Pipe

Size

Size of Main

Repair—Renewal—New Service

Location

Date

Material

Amount

Total

Date

Amount

1.4.07

4x6 CI to PVC
6" 45° Bend At Cast Iron
124' - 6" PVC

6x6x6 wye Clean out
6x6 PVC to AC
FRANCO


11.26.75

32' - 6" ACP Pipe

DATE _____

TOWN OF LEXINGTON — BOARD OF PUBLIC WORKS

SEWER DIVISION

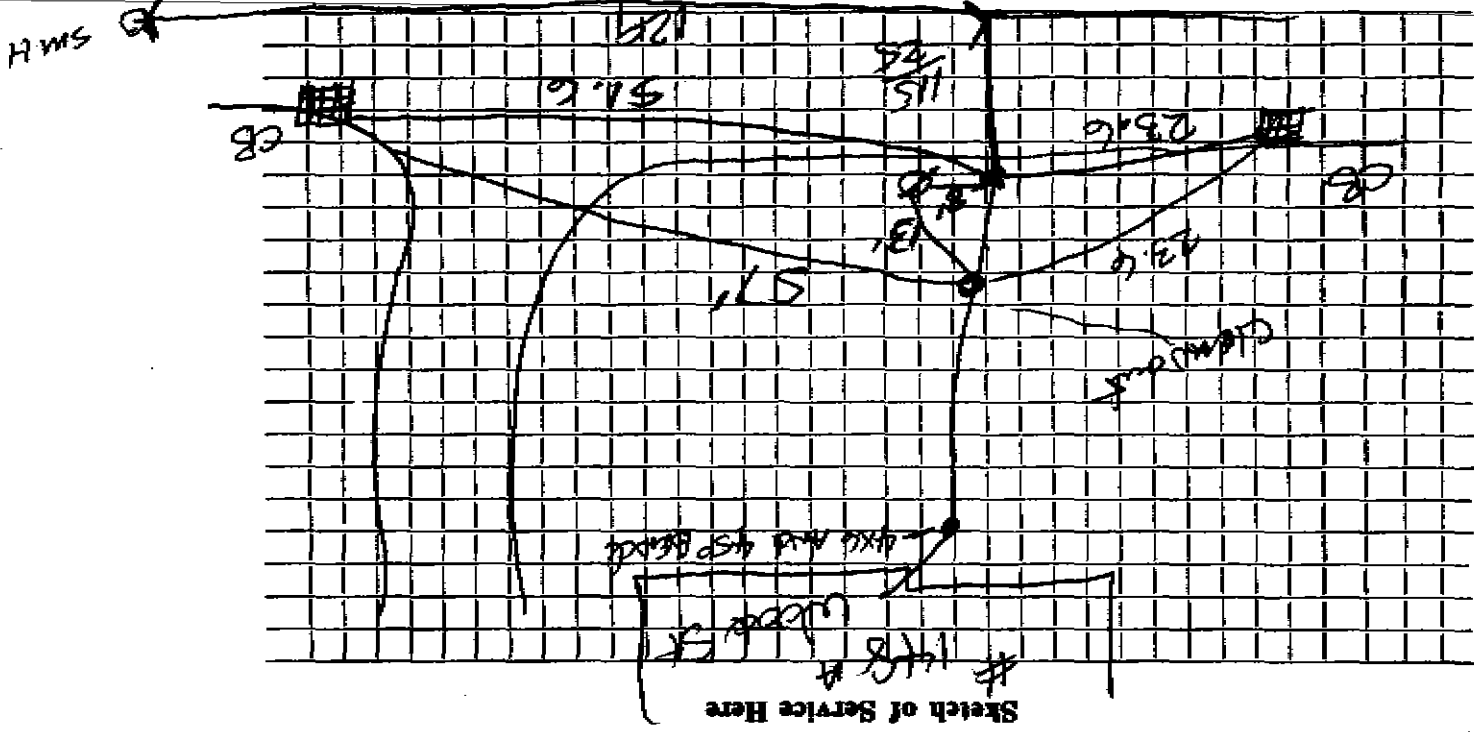

Connection made in _____ Street.
SEWER IN STREET WAS REPAIR UNDER WATER MAIN??
REPAIR HAS SETTLED - NEEDS TO BE DONE AGAIN?
Remarks:

Work completed