


TOWN OF LEXINGTON — BOARD OF PUBLIC WORKS

SEWER DIVISION

DATE

149

Sketch of Service Here

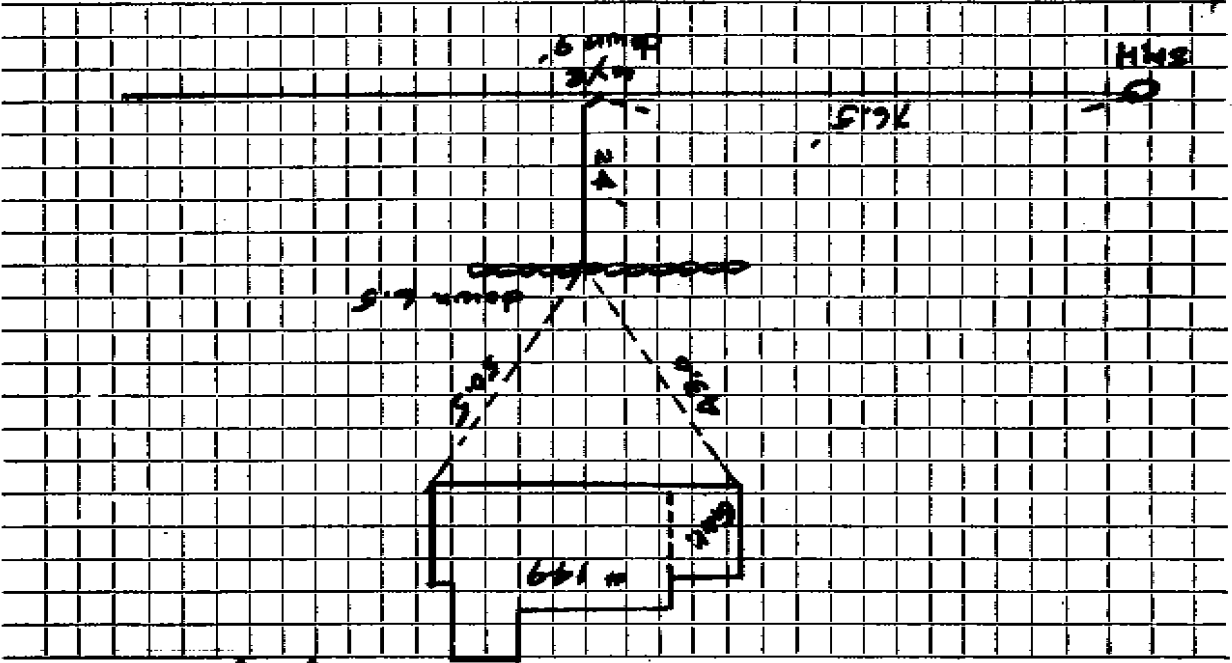

Street. Work completed

Connection made in Wood St
Remarks: Service under driveway